

BLOCK 11

GLADYS AVENUE

SECOND STREET



THIRD STREET

MAIN STREET

BLOCK 5

HURLBERT AVENUE

BLOCK 2

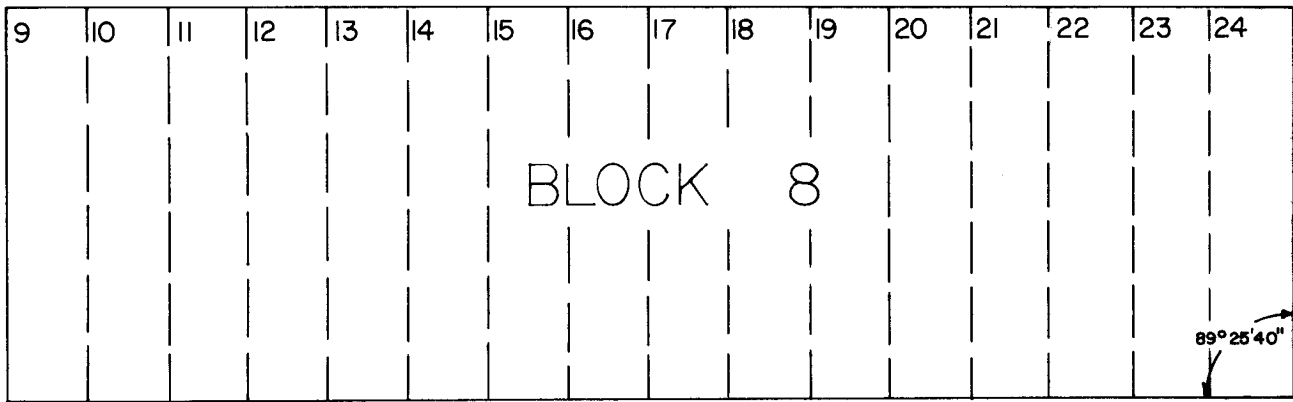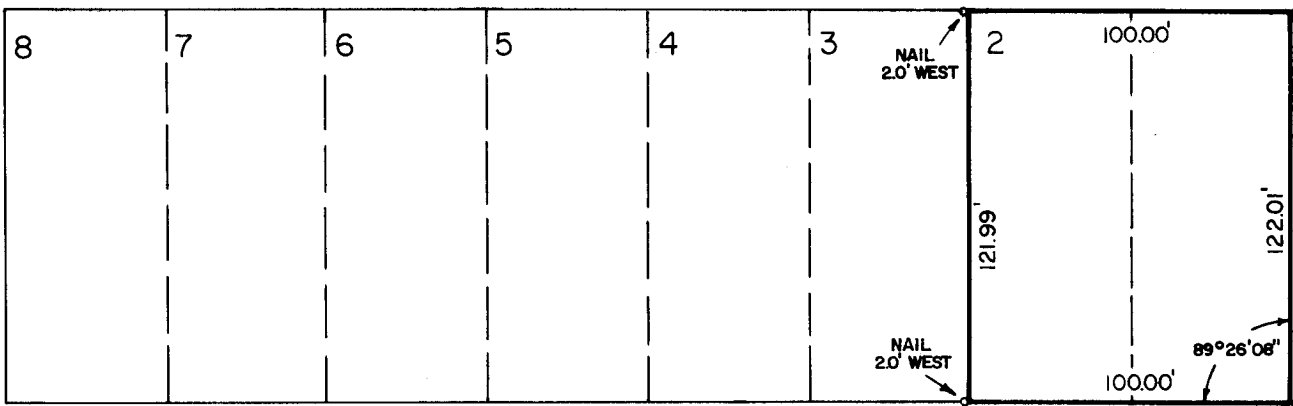

465.62' (465.00)

333.02'
842.06' (842.00')

NAIL & WASHER

FOUND 1" IRON BAR SET 1/2" I.R. AT SURFACE

SMALL P.K. NAIL

LARGE P.K. NAIL 0.95' SE.

NAIL 2.0' WEST

NAIL 2.0' EAST

NAIL 2.0' WEST

NAIL 2.0' EAST

89°25'40"



L-100-A

REGISTERED PROFESSIONAL LAND SURVEYOR

G. Dennis Edwards

OREGON
JULY 16, 1971
G. DENNIS EDWARDS
951

SURVEY FOR GEORGE CORRIGAN

LOCATION LOTS 1 & 2, BLOCK 8, TOWN OF HERMISTON, SEC. 11, T 4 N, R 28 E, W.M., UMATILLA COUNTY, OREGON

DATE: 10-26-76 SCALE: 1" = 60'

● MONUMENTS FOUND (000) OF RECORD
○ NAILS SET

JOB NO. S7610274

EDWARDS SURVEYING
567-3336

P. O. Box 763
Hermiston, Ore.