




Computed from W.C.

Computed from W.C.

Found W.C. Spike

Set 1/2" Iron Pipe

- ⊙ Denotes R.R. Spike Set
- Denotes 1/2" Iron Pin Set
- Denotes 5/8" Iron Pin Set

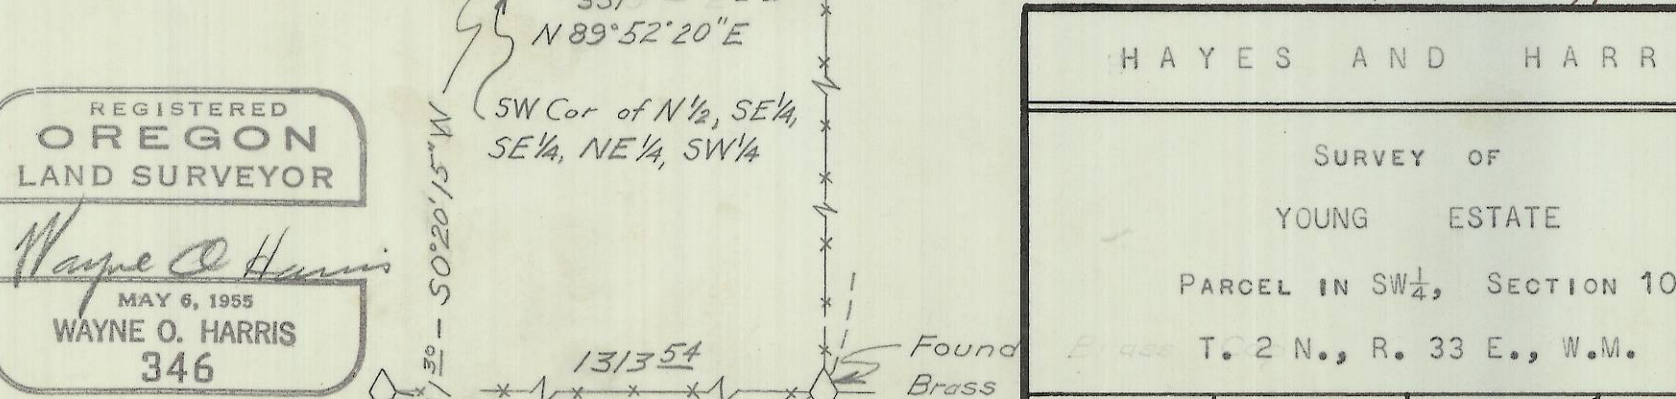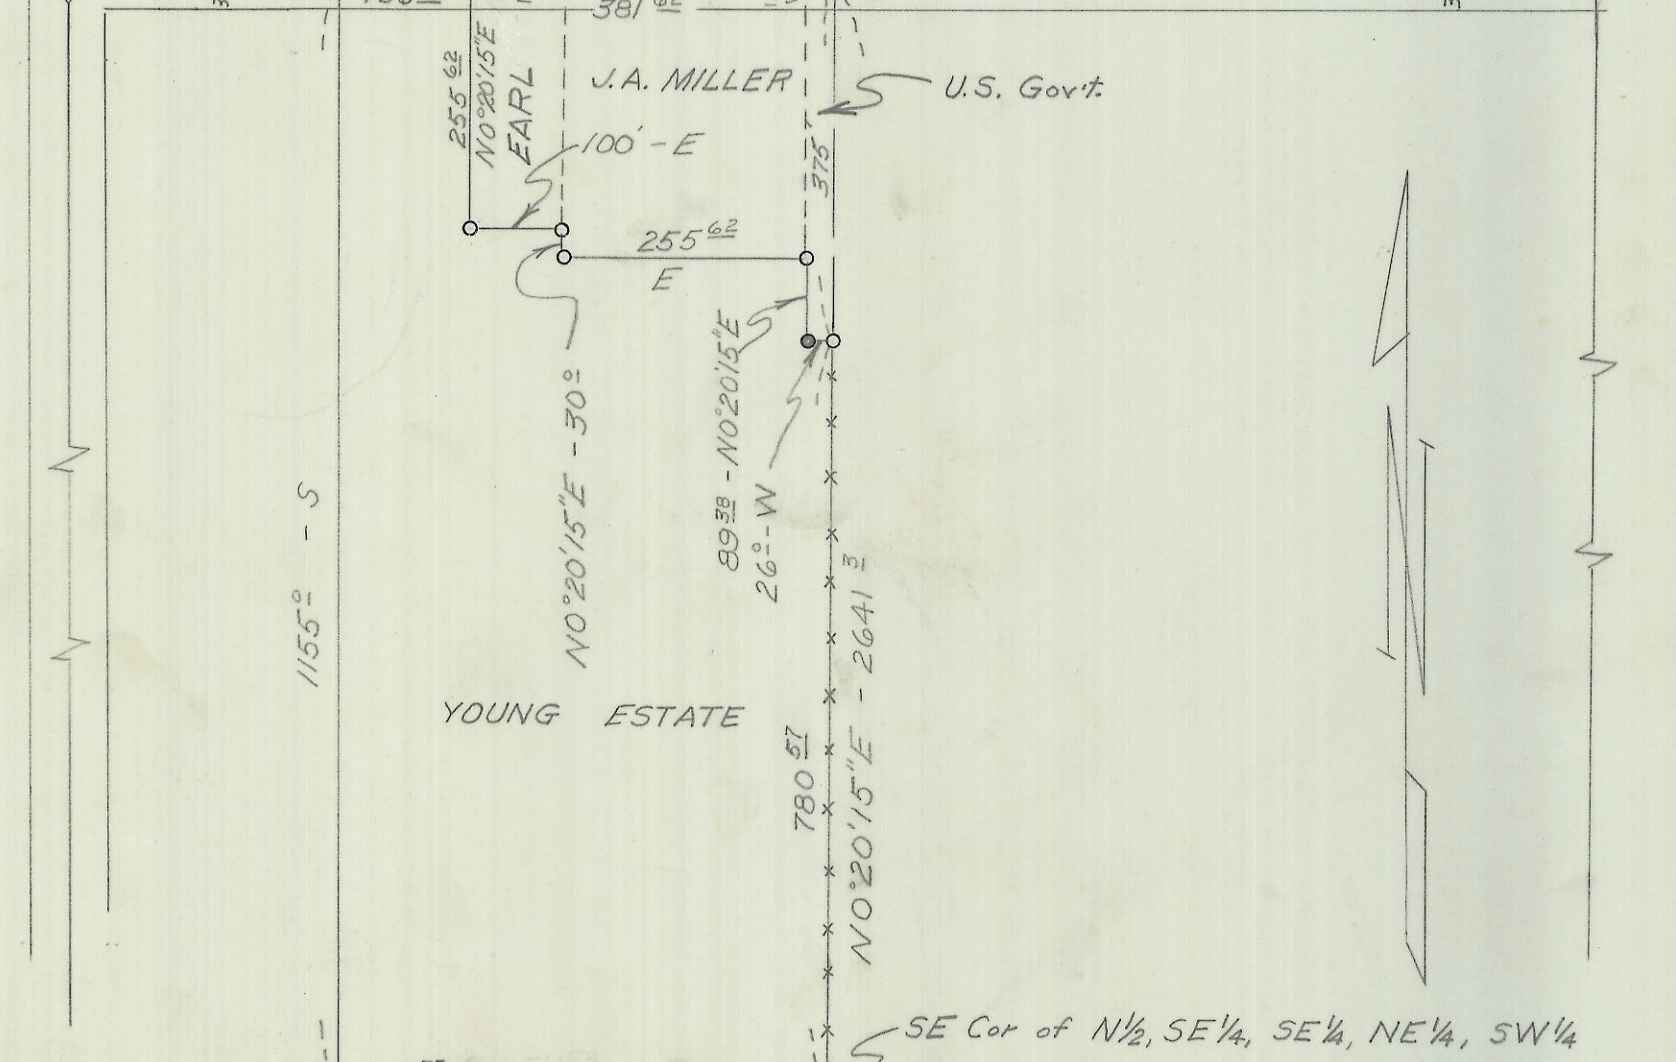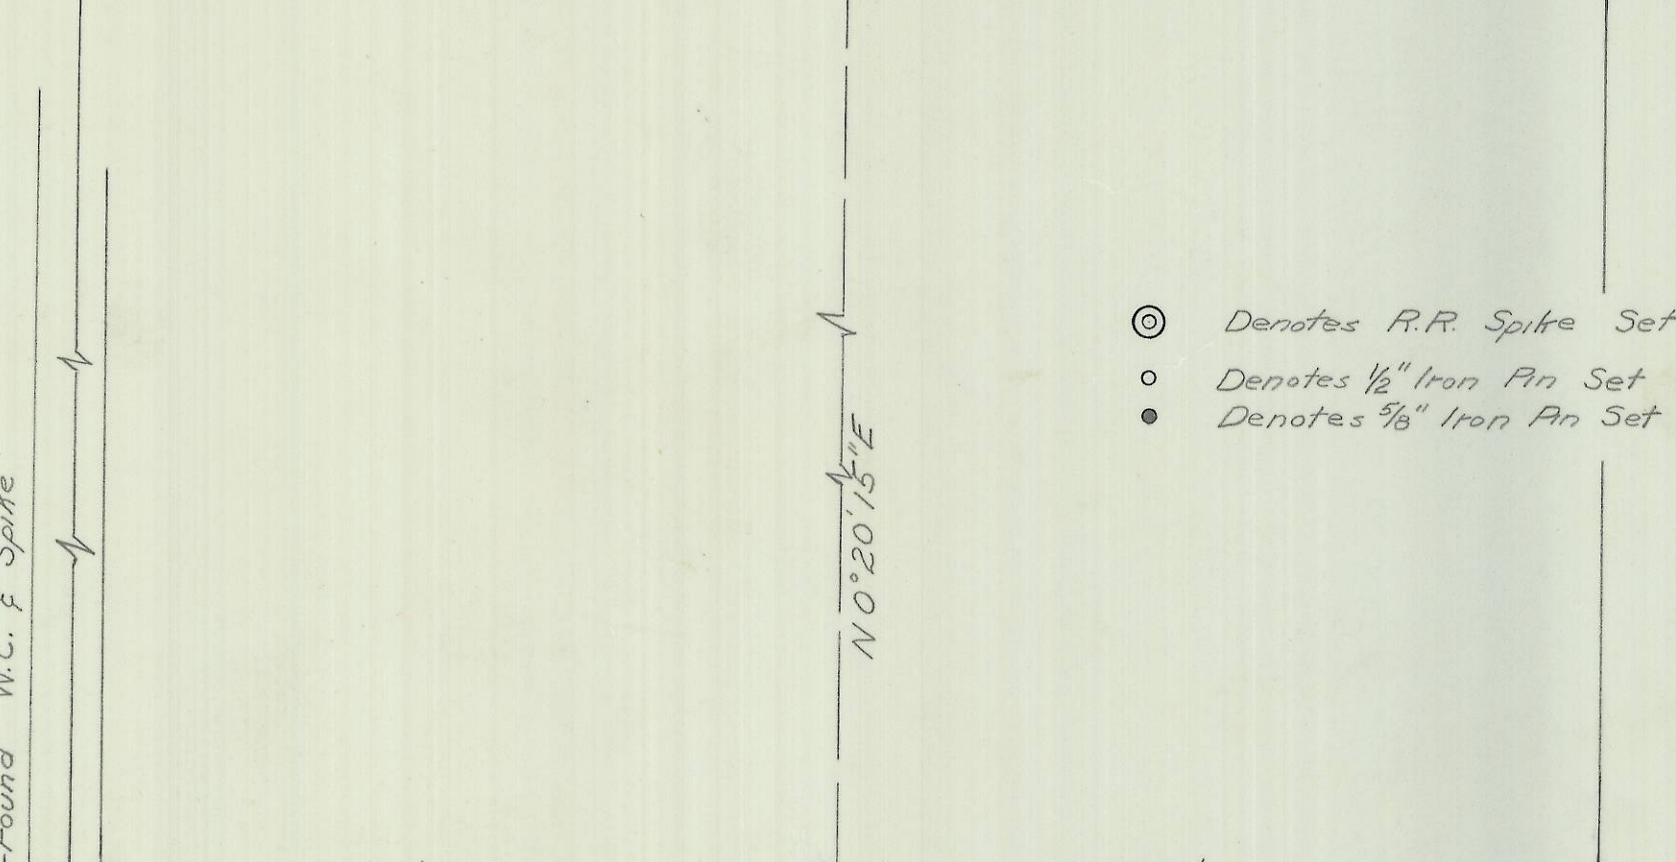

REGISTERED  
OREGON  
LAND SURVEYOR

*Wayne O. Harris*  
MAY 6, 1955  
WAYNE O. HARRIS  
346

Found Fence Cor for 1/16 Cor.

Q-477-A

HAYES AND HARRIS

SURVEY OF  
YOUNG ESTATE  
PARCEL IN SW 1/4, SECTION 10  
T. 2 N., R. 33 E., W.M.

SCALE	DATE	DRN. BY	DRNG. NO.
1"=200'	10/24/61	L.H.A.	61-113A

Q-477-A