


N.E. Cor. of N.W $\frac{1}{4}$
Sec. 32, T.3. N.R. 33

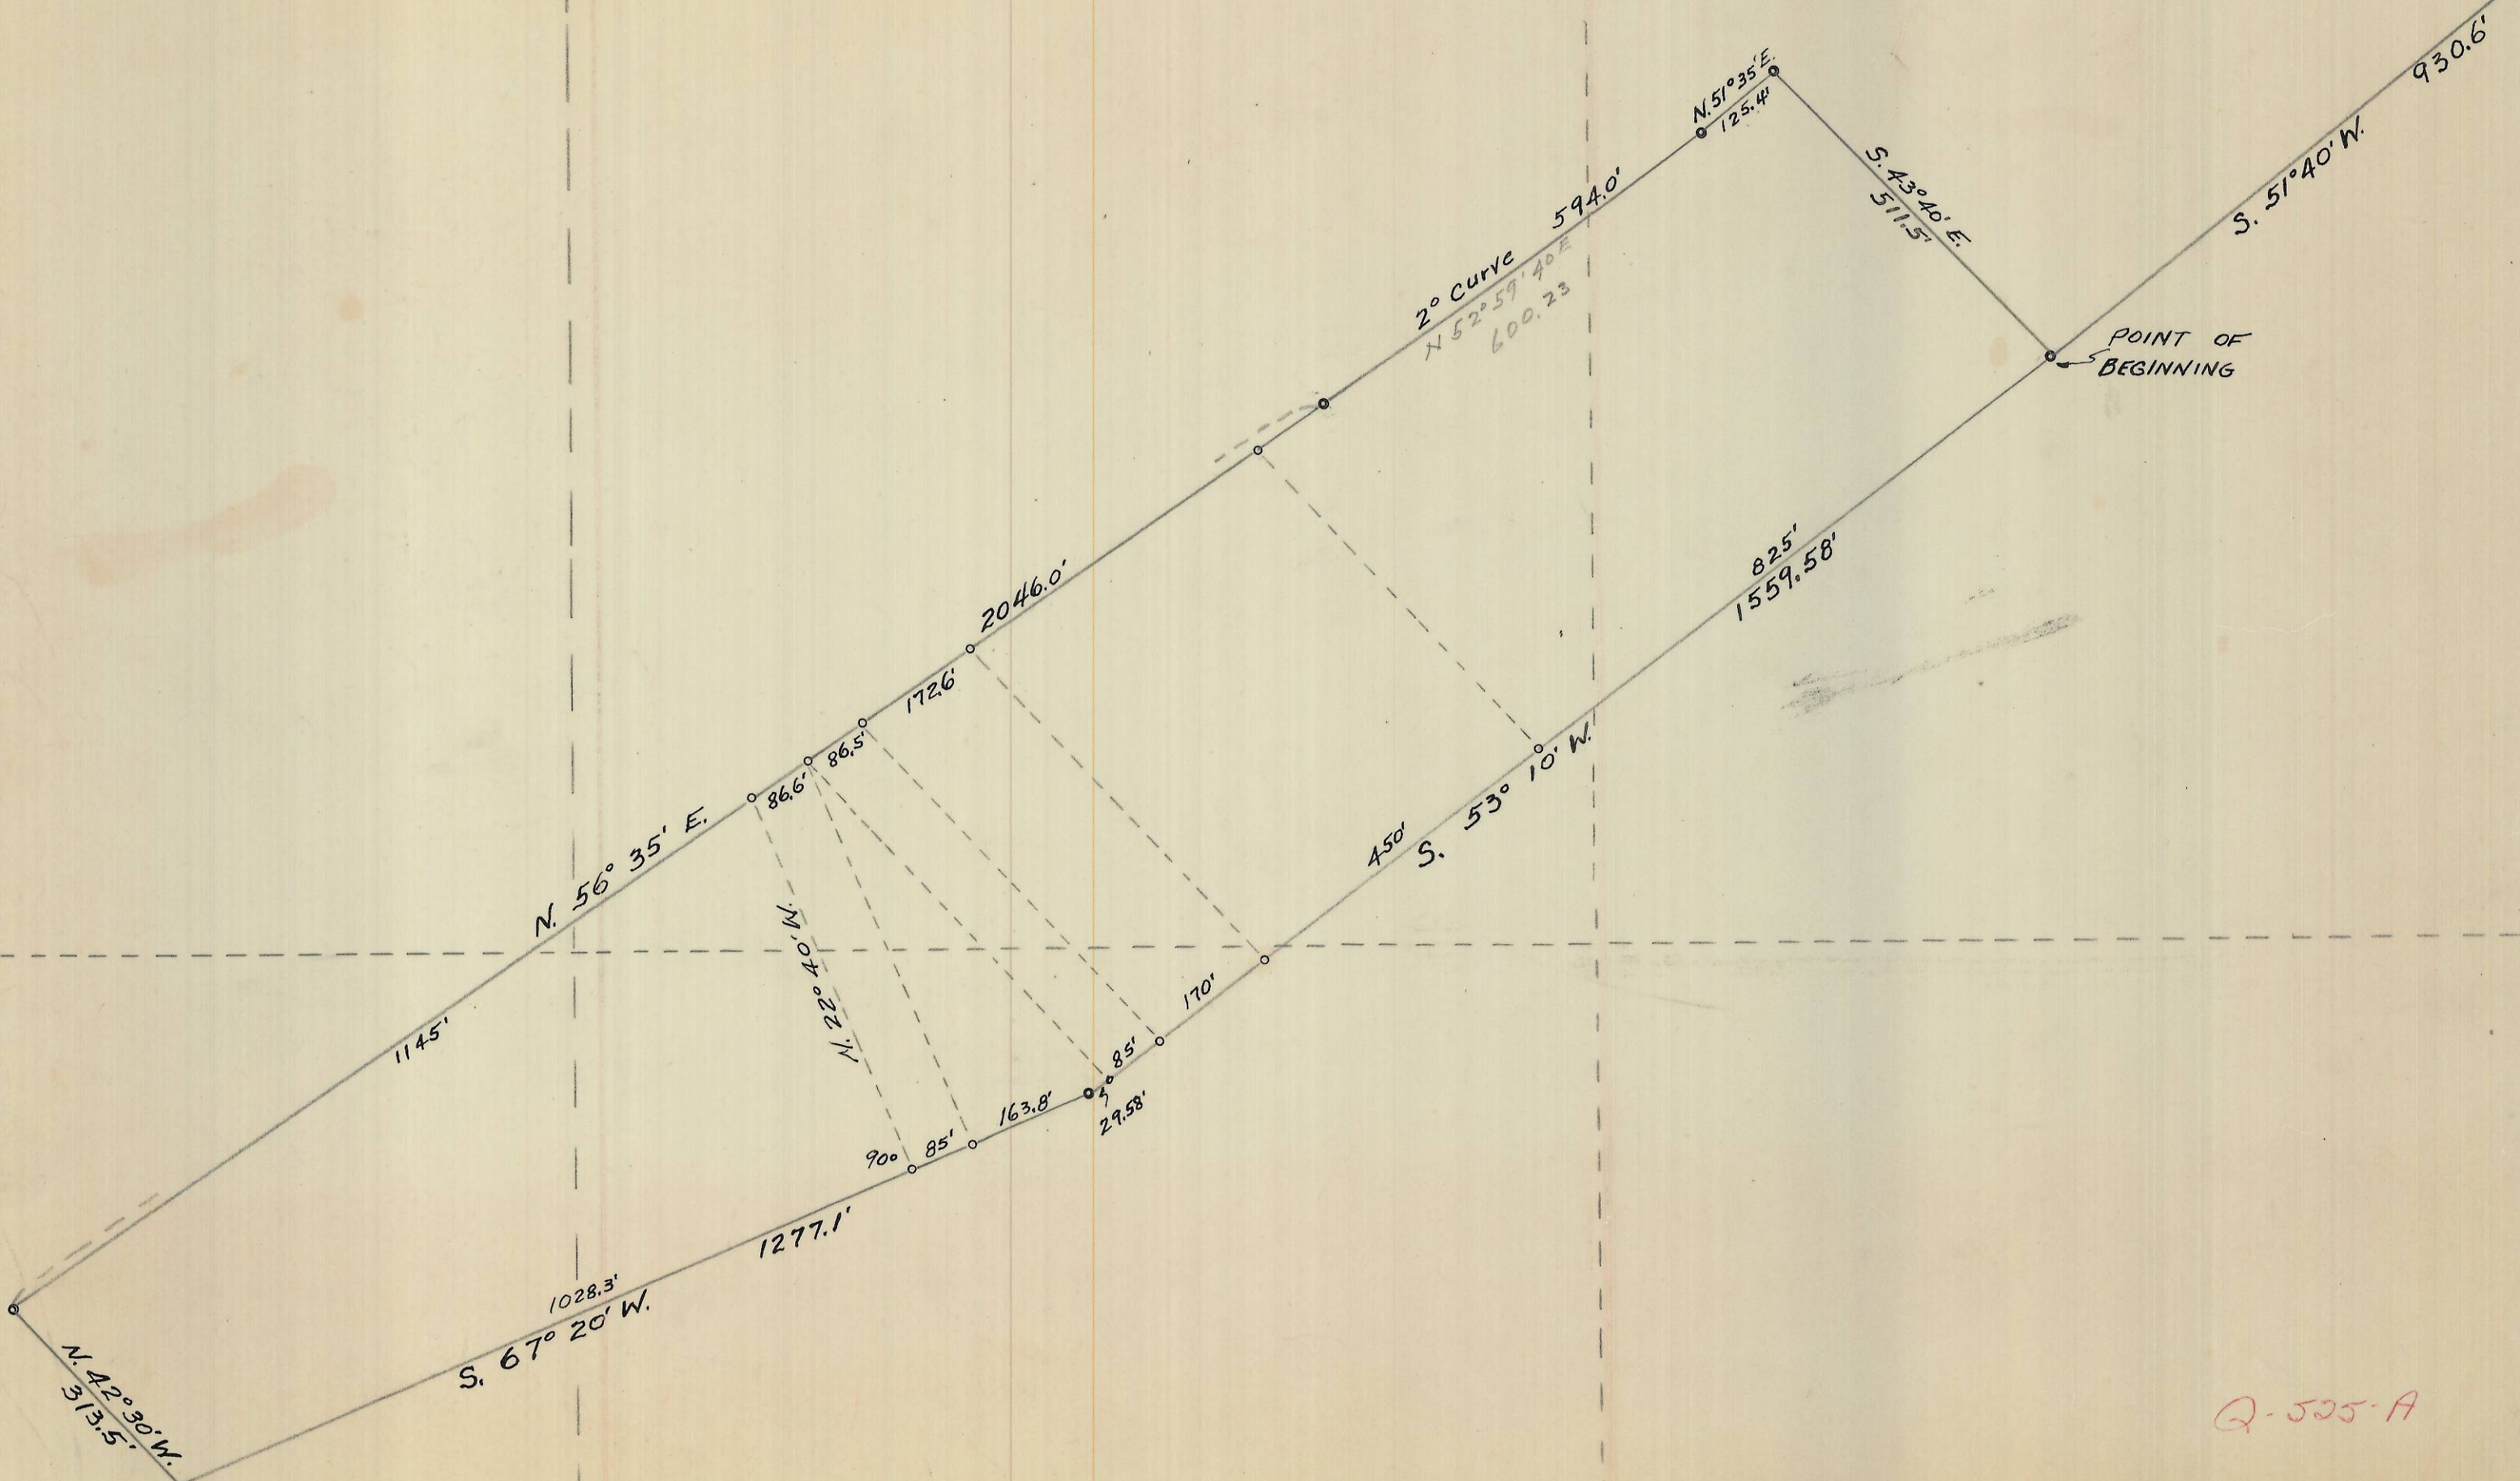

Q-525-A