


NOTE:  
Bearings from previous surveys  
on file with the Umatilla County  
Surveyor.

LEGEND:  
● Denotes points found  
○ Denotes 1/2" iron pins set unless  
otherwise noted

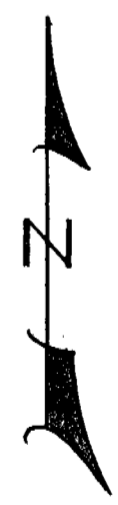

Q-571-Ax

Survey for LaVerne Boylen and Albert Marcheck, situated in the NE 1/4 of the SW 1/4 of Section 8, T. 4 N., R. 28 E., W.M., Umatilla Co.		WAYNE HARRIS CO. INC. ENGINEERS - SURVEYORS PENDLETON, ORE.			
DATE	SCALE	DRN. BY	CKD BY	DRGN. NO.	
12-10-75	1"=300'	C.T.P.	E.J.H.	75-365A	