

County Road No. 15

State Highway To Walla Walla

DEPARTMENT OF ROADS
 COUNTY OF UMATILLA
 PLAT OF


COUNTY ROAD NUMBER 303
 AS NOW TRAVELLED.

APPROVED

James H. Stung
 County Judge

J. E. Olinger
 County Commissioner

Claude Meyers
 County Commissioner

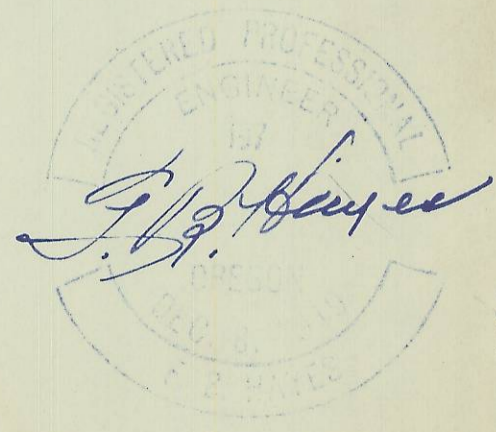

Scale 1" = 100'

SC 15 TO 4 NR 35

1013

A-713-A

Road No. 303 Located In North City Limits of Weston

Beginning at the Southeast corner of the Southwest Quarter of Section 15, Township 4 North, Range 35 E.W.M. Thence West a distance of 130.0 feet to Engineers Station 1 plus 30.0 P. C. Thence on 286.48 foot Radius Curve to the Right (The long chord of which bears North $75^{\circ}58'$ West a distance of 138.77 feet) The Arc distance which is 140.17 feet to Engineers Station 2 plus 70.16 P.T. Thence North $61^{\circ}58'$ West a distance 9.8 feet to Engineers Station 2 plus 79.96 P.C. Thence on a 818.51 foot Radius Curve to the Right the (long chord of which bears North $54^{\circ}58'$ West a distance of 199.50 feet) the Arc distance which is 200.0 feet to Engineers Station 4 plus 79.96 P.T. Thence North $47^{\circ}58'$ West a distance 111.6 feet to Engineers Station 5 plus 91.56 P.C. Thence on a 954.93 foot Radius Curve to the Right (The long chord of which bears North $36^{\circ}50'30''$ West a distance of 368.51 feet) The Arc distance which is 370.83 feet to Engineers Station 9 plus 62.39 P.T. Thence North $25^{\circ}43'$ West a distance of 312.03 feet to Engineers Station 12 plus 74.42 P.C. Thence on a 112.34 foot Radius Curve to the left (The long chord which bears North $51^{\circ}07'45''$ West 96.42 Feet) The Arc distance which is 99.65 feet to Engineers Station 13 plus 74.07 P.T. Thence North $76^{\circ}32'30''$ West a distance of 5.12 feet to Engineers Station 13 plus 79.19 feet P.C. Thence on a 133.25 foot Radius Curve to the Right (The long chord of which bears North $54^{\circ}58'$ West a distance 98.0 feet) the Arc distance which is 100.35 feet to Engineers Station 14 plus 79.54 P.T. Thence North $33^{\circ}23'30''$ West a distance of 301.06 feet to angle point engineers station 17 plus 80.6 Thence North $32^{\circ}01'30''$ West a distance of 172.0 feet to Engineers Station 19 plus 52.6 P.O.T. Said point intersecting East and West center line of Southwest Quarter of Section 15, Township 4 North, Range 35 E.W.M.

Q-713-A