

22A 9999



22A

227

1118 9999

1118

Q-927-A

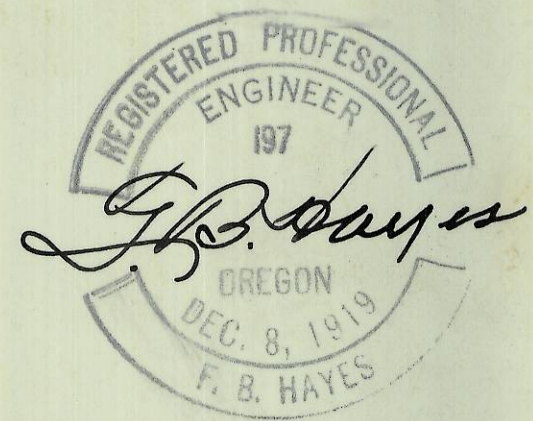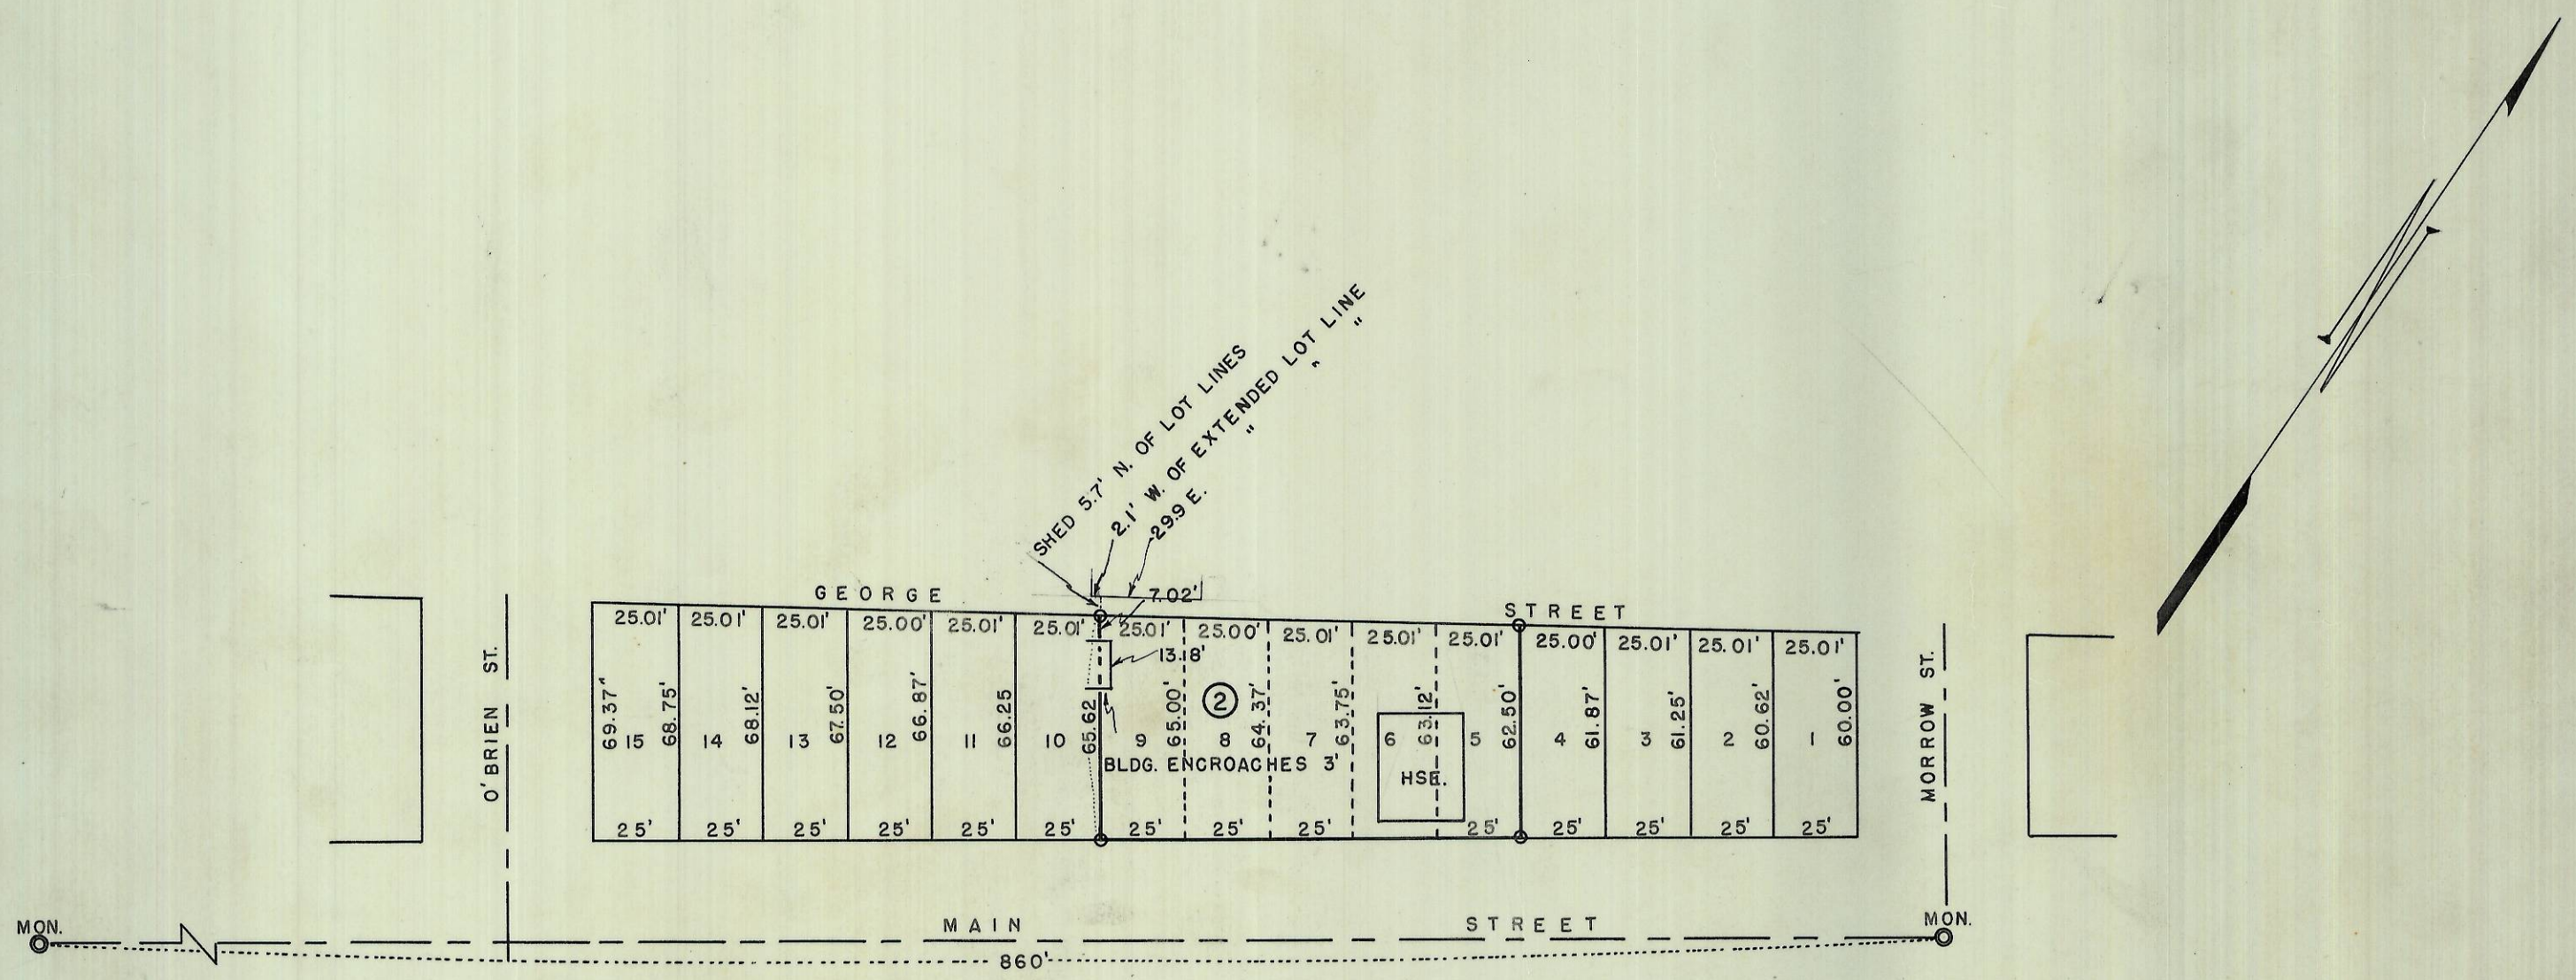

Q-927-A

HAYES & HARRIS ENGINEERING		
SURVEY FOR UNION PACIFIC RAILWAY CO. LOTS 5, 6, 7, 8, & 9, BLOCK 2 RIETH, OREGON		
SCALE 1" = 50'	DATE 4-6-55	DRAWN BY W. O. H.

T2NR32 7CC