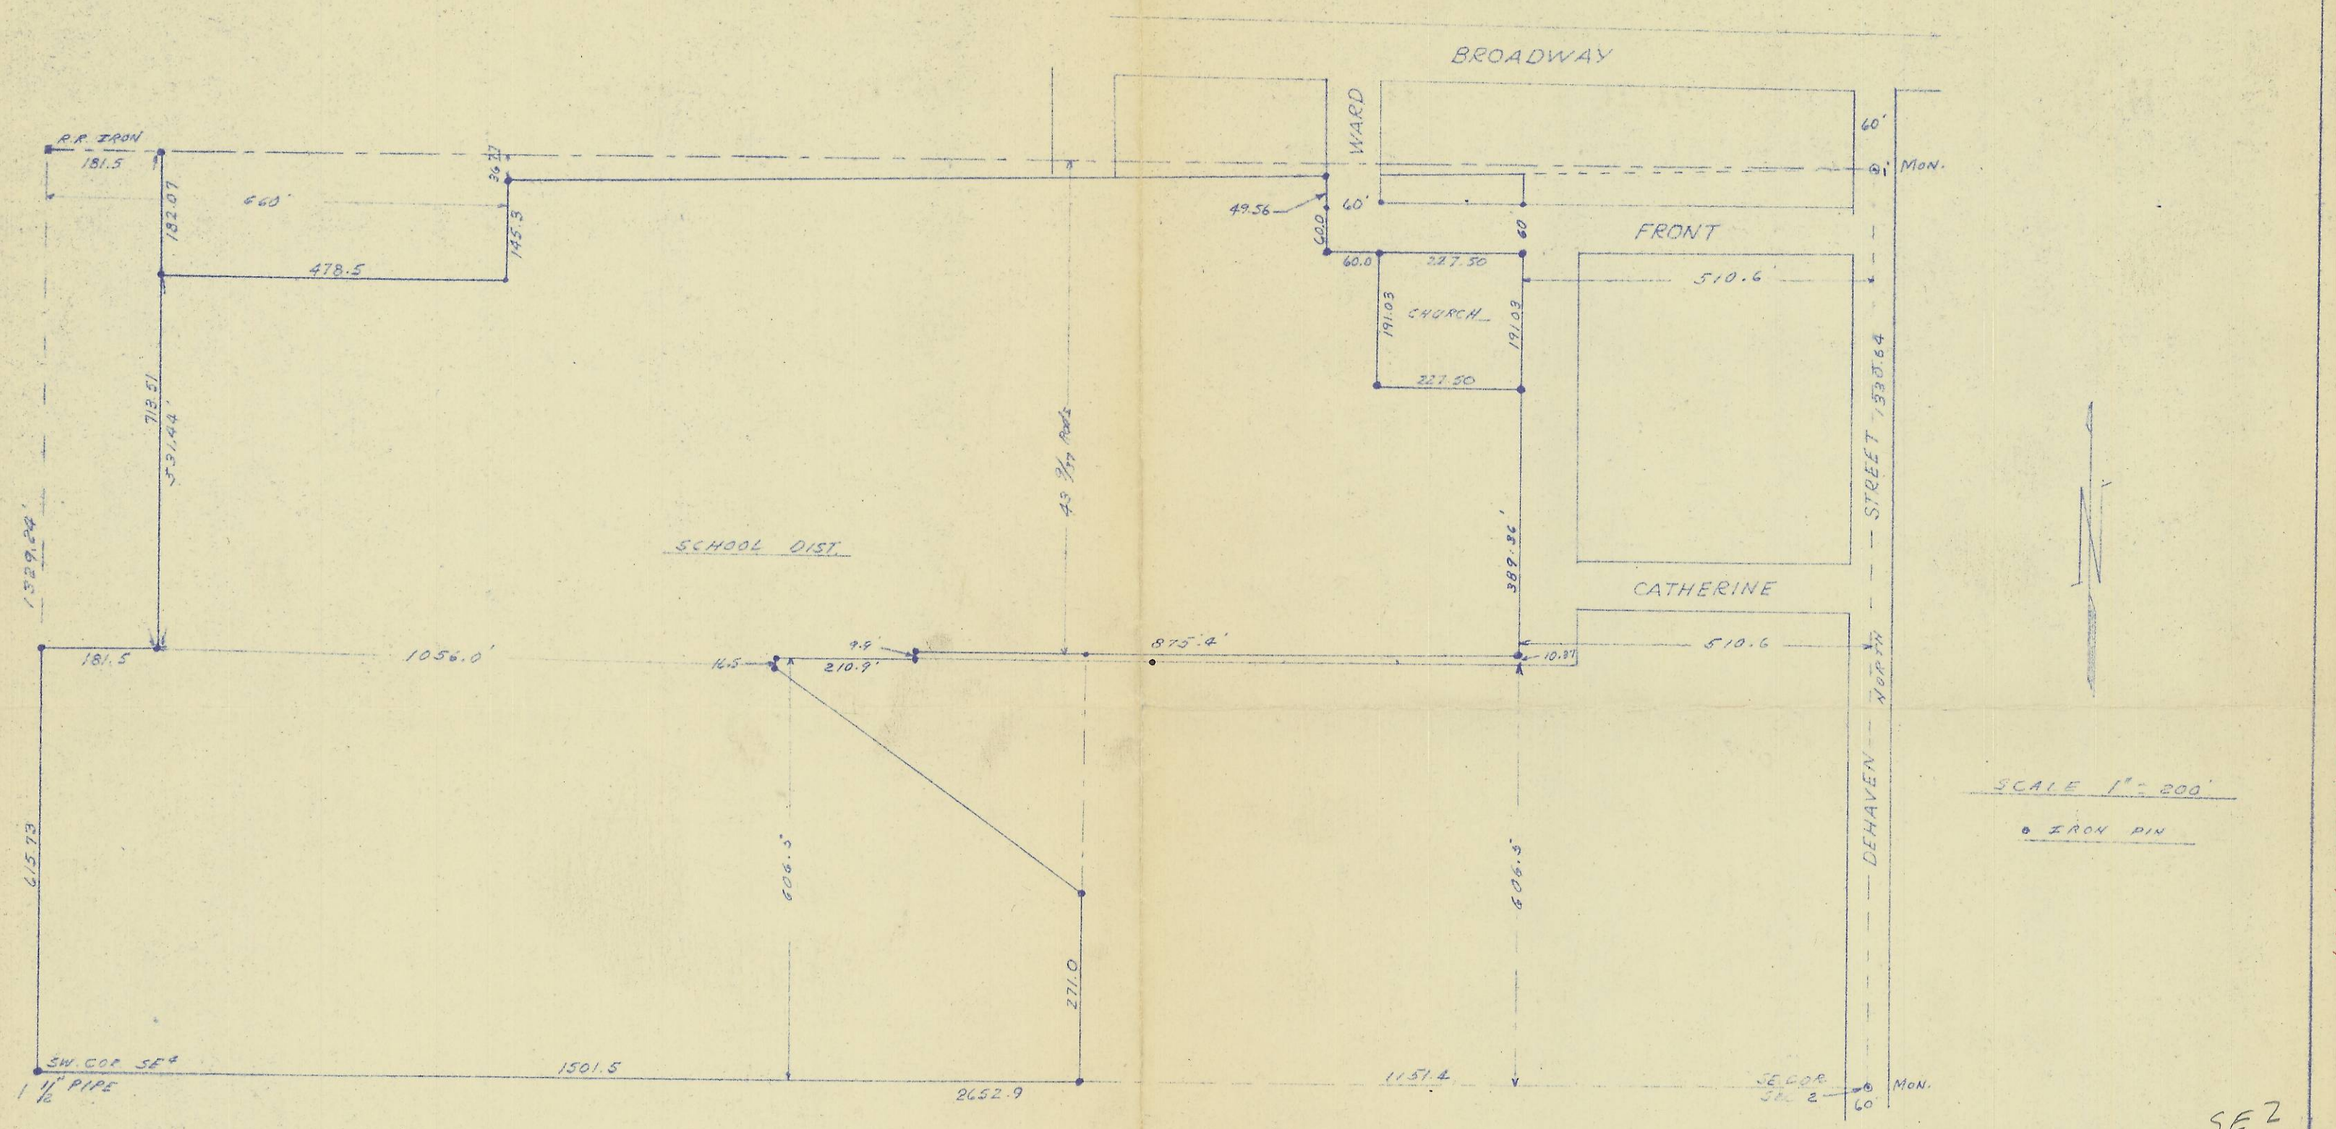
BROADWAY
WARD
FRONT
CATHERINE
CHURCH
SCHOOL DIST.
R.R. IRON
181.5
660'
478.5
182.07
145.3
36.77
713.51
531.44'
1329.24'
49.56
60.0
60'
227.50
191.03
510.6'
389.36'
875.4'
10.37
1056.0'
16.5
9.9'
210.9'
606.5'
271.0
615.73
1151.4
1501.5
2652.9
SW. COR. SE4
1 1/2" PIPE
SE COR. SEC. 2
MON.
DEHAVEN STREET
NORTH
SCALE 1" = 200'
IRON PIN
SE2
5N35-2
REGISTERED
OREGON
LAND SURVEYOR
G. M. Newbill
MAY 6, 1949
G. M. NEWBILL
255
G. M. NEWBILL
LICENSED LAND SURVEYOR
17 N. Second
Walla Walla, Wash.
Phone 4170
Surveys
Descriptions
Sub Divisions
A SURVEY
FOR
MILTON SCHOOL DISTRICT
SEC. 2 T. 5N R. 35 EWM
Date 6/28/55
Drawn By GMN
Checked By
No. 1687
5N352DA
Q-1609-A