


NOTE: N'LY LOT LINE PER THIS SURVEY IS $\pm 3.0'$ N/O RELATIVELY NEW FENCE. MRS. HAYES, OWNER OF THE LOT, STATES THAT A VERY OLD FENCE WHICH WAS RECENTLY REMOVED, WOULD APPROXIMATE THE LINE AS MONUMENTED.

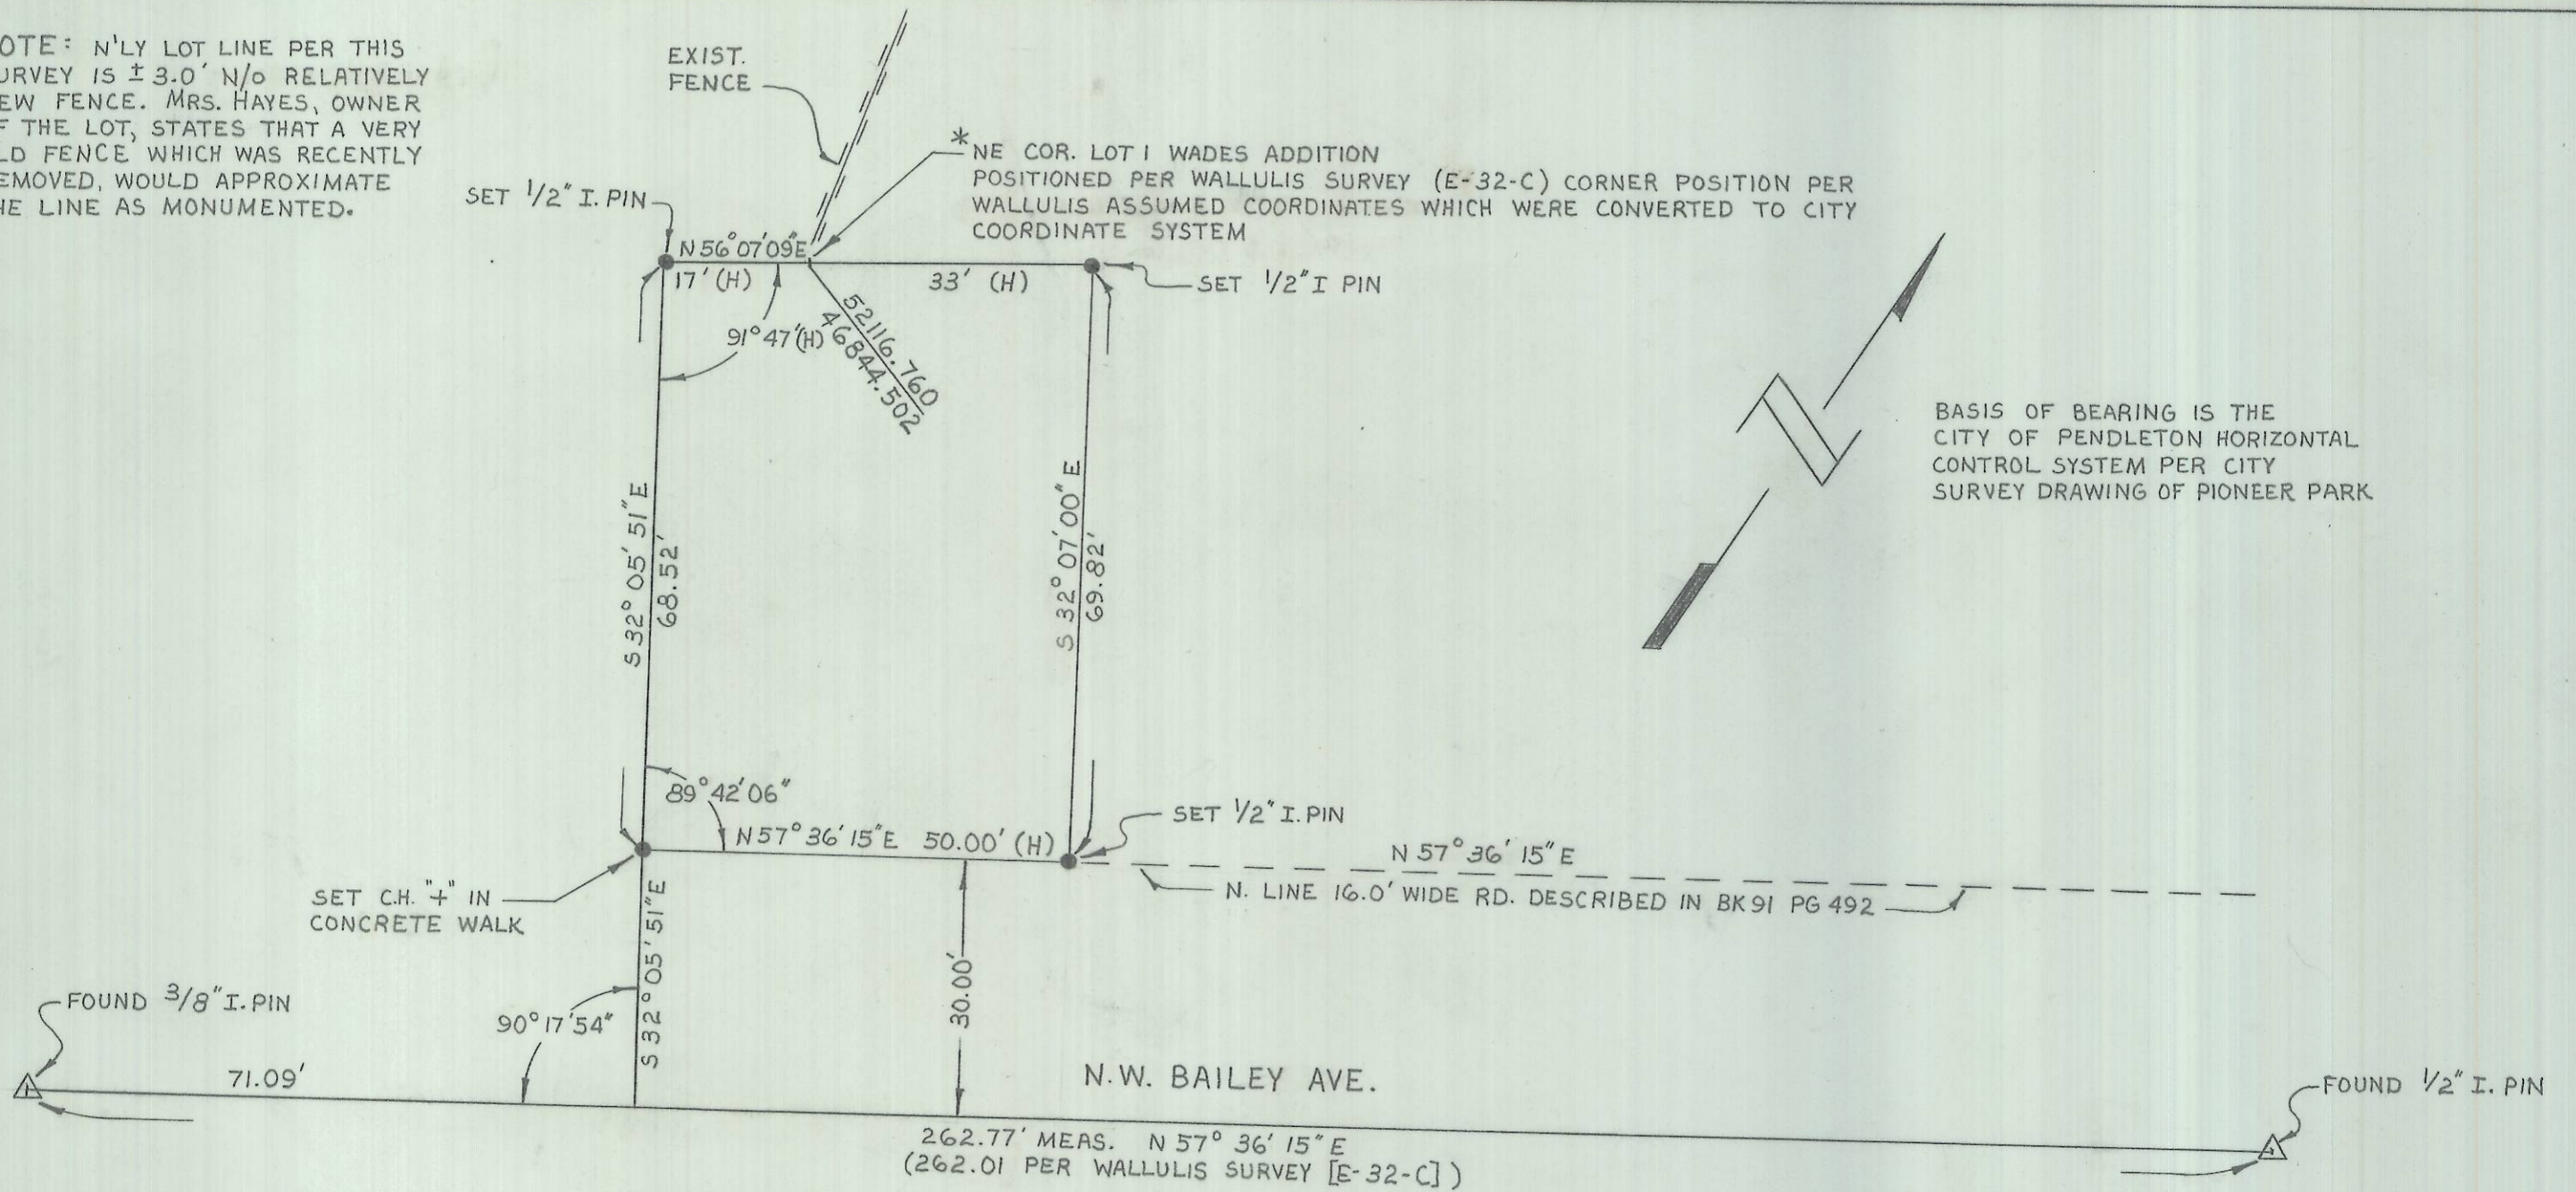

(H) = HELD PER DESCRIPTION

REGISTERED
PROFESSIONAL
LAND SURVEYOR

Wayne O. Harris
OREGON
MAY 6, 1955
WAYNE O. HARRIS
346

WAYNE HARRIS CO. INC.
SURVEYORS
PENDLETON, OREGON

SURVEY FOR MARTHA HAYES
OF DESCRIPTIVE PARCEL BK 268
PG 304 IN PENDLETON, OREGON

SCALE	DATE	DRN.	CHK.	DWG. NO.
1" = 20'	10-22-79	FLM	<i>FLM</i>	79-443A

Q-1190-A