


NOTE 'A':
 FOR EXPLANATION OF THE DIFFERENCE BETWEEN
 THESE CORNERS, SEE EDWARDS 1978 SURVEY FOR
 MYRICK & TINDOL, ET AL.

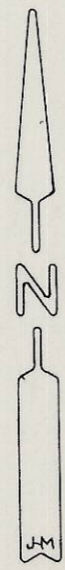

REGISTERED
 PROFESSIONAL
 LAND SURVEYOR

G. Dennis Edwards

OREGON
 JULY 16, 1971
 G. DENNIS EDWARDS
 951

RECEIVED BY
 Umatilla County Surveyor
 Date 12-81
 Rec'd By BLS
 No. S-128-A

SURVEY FOR DICK MAXWELL
 LOCATION NE 1/4 SE 1/4 NE 1/4
 SEC. 5 T 4 N, R29 E, W.M., UMATILLA COUNTY, OREGON
 DATE 9/25/81 SCALE: 1" = 100'
 • MONUMENTS FOUND (000) OF RECORD
 • IRON RODS SET JOB NO. 78106090
 EDWARDS SURVEYING P. O. Box 763
 567-3336 HERMISTON, ORE.

S-128-A