


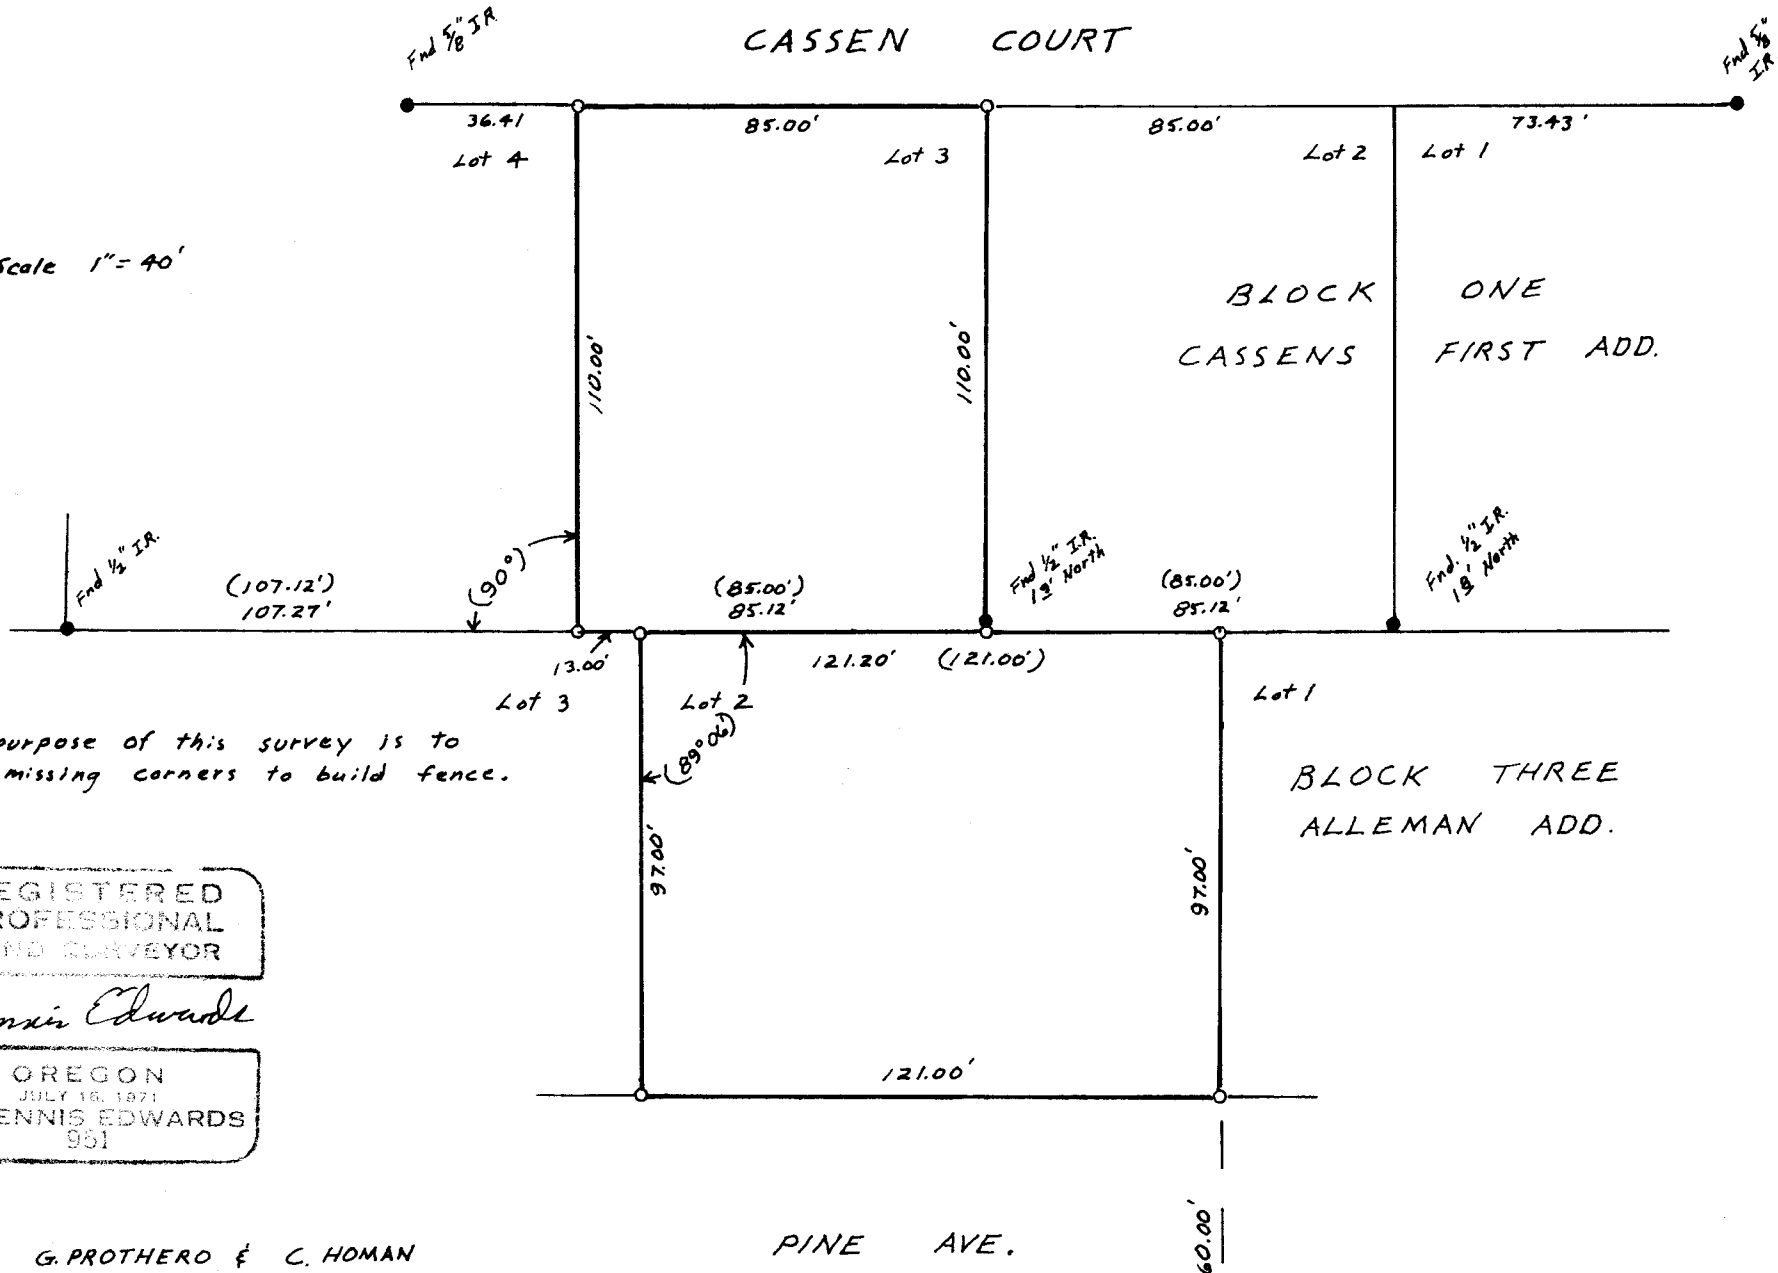

Scale 1" = 40'



The purpose of this survey is to set missing corners to build fence.

REGISTERED PROFESSIONAL LAND SURVEYOR

G. Dennis Edwards

OREGON JULY 16, 1971 G. DENNIS EDWARDS 951

SURVEY FOR G. PROTHERO & C. HOMAN in CASSENS 1st Add. & Alleman Add. 1/4 SW 1/4 SE 1/4 Sec. 11, T4N, R28E, W.M. UMATILLA CO. OREGON. 4/29/83

Monuments Fnd. 0 1/2" I.R.s set (00) of record Job # 5 8304033

EDWARDS SURVEYING R.O. Box 763 HERMISTON, OR. 567-3336

83-142-AX

Lot 9 Lot 10 BLOCK TWO ALLEMAN ADD.