


SCALE: 1" = 400'  
DATE: April 26, 1991

LEGEND

- ⊙ - - - - Found Brass Caps (B.C.) as shown 2 1/2" O.D.
- - - - - Set 5/8 x 30" Rebar Pin with Red Plastic Cap Stamped R.L.S. 1333

NARRATIVE

This survey was performed to set the N.W. corner of the N.E. 1/4 of the N.E. 1/4 of section 17, T1N, R34E.W.M. and to mark the north boundary thereof. The field notes of Wilkes survey done in 1917 was used and the brass caps he set and I found as shown were also used for control. I measured the distance between the brass caps and proportioned it for the 1/16 corner according to the manual of instructions and used Wilkes bearing of S 89° 56' E for the said line. The deed used is recorded in book 337 on page 294 of the deed records.

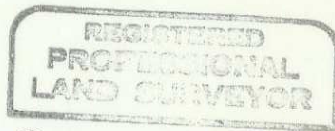

Donald L. Staebler



SURVEY FOR KEN MITCHELL and Kathy Snyder of the N. Boundary of the N.E. 1/4 of the N.E. 1/4 of Sec. 17, T1N, R34E.W.M.

Scale: 1" = 400' DATE: 4-26-91

By: Donald L. Staebler  
Engineer - Surveyor  
1532 S.W. 41 ST.  
Pendleton, Or. 97801

RECEIVED BY

Umatilla County Surveyor

Date 6-91

Rec'd By XA

No. 91-42-AX

91-42-AX