


S.W. 17th ST.

S.W. 18th ST.

RESERVATION
ADDITION
TO THE CITY OF
PENDLETON, ORE.

99

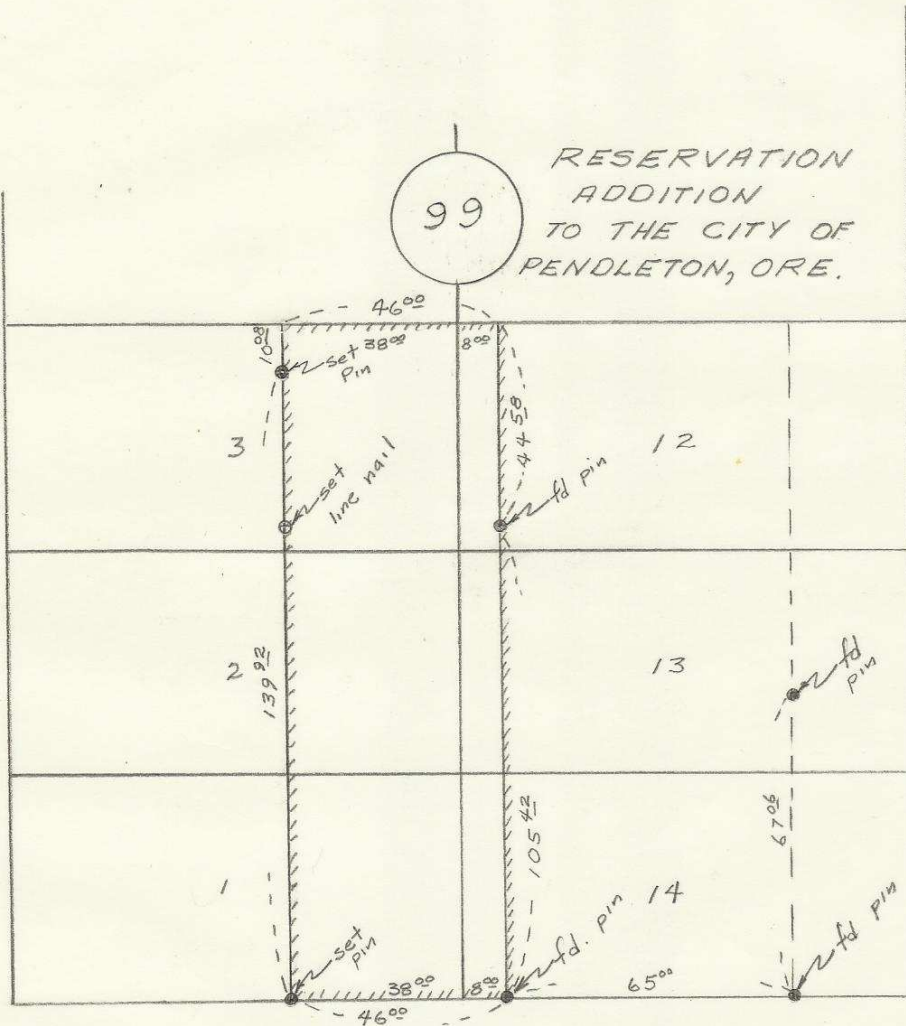

S.W. FRAZER

2N3210CA

LOT SURVEY FOR
FORREST LEROY BAKER


Scale: 1" = 40'

DATE: 2-15-61

STANLEY G WALLULIS
CONSULTING ENGINEER
P.O. Box 91

PENDLETON

OREGON

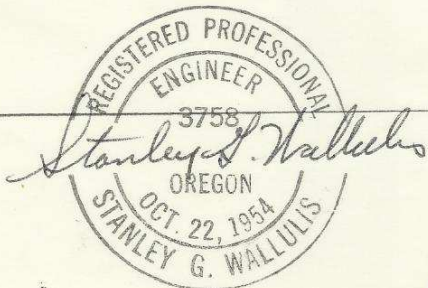

99-219-AX