


Field Notes

By: Tenneson & Associates

Date: Nov. 6, 1956 - Cold & Clear

Location: Lot 11, Block 3 of Livermores. Second Addition to the City of Pendleton, Oregon

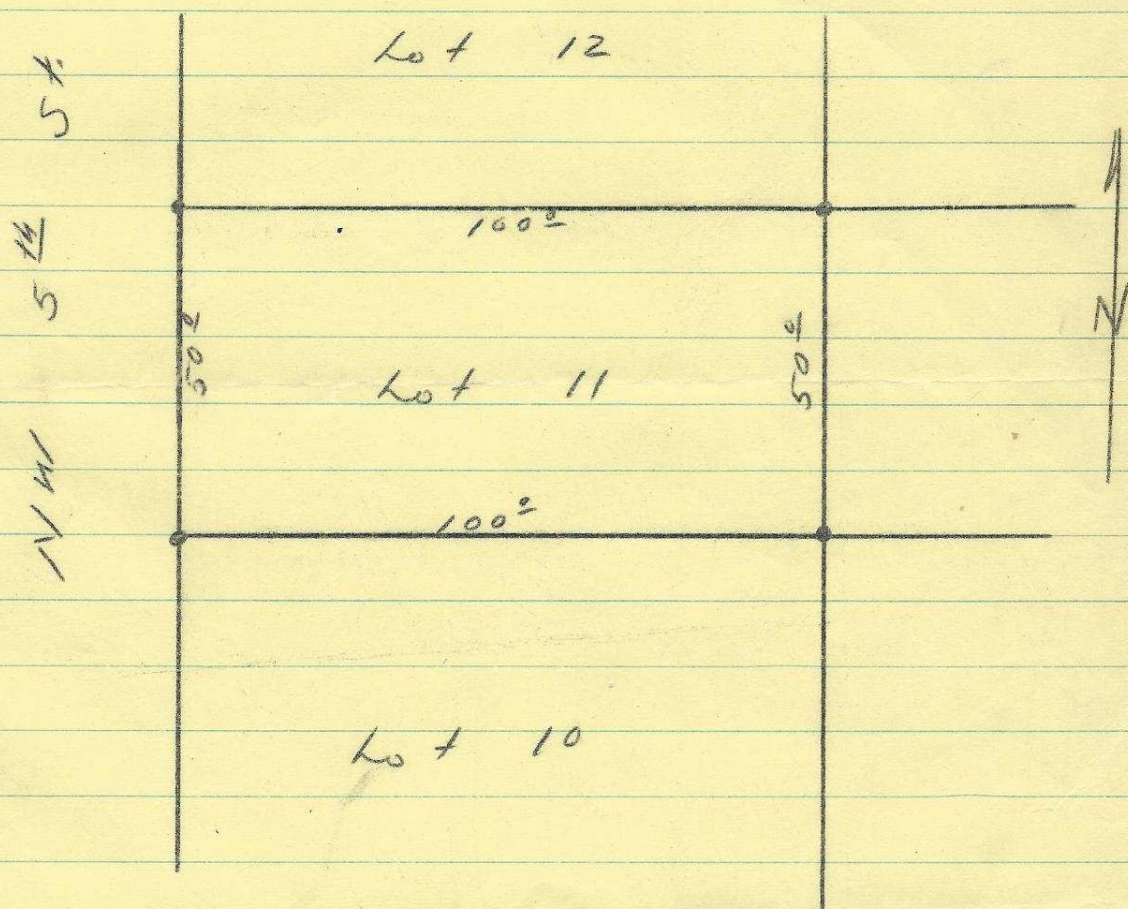

Legend

• - pins set

2N32 3DC
04-198-Ax