


N. W. 12th St.

N. W. Furnish Ave 60'

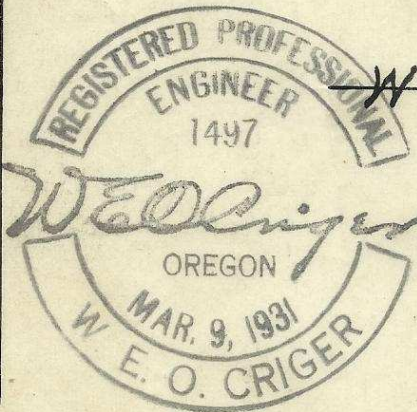

20323CD

Plat showing parts of  
 Blocks 7 and 8 of  
 Irvington Heights Addition  
 to the City of Pendleton, Ore.  
 surveyed, staked and plotted.  
 May, 1951 - Oct. 1952 -  
 By W. E. O. Criger.  
 Scale: 1 in. = 50 Ft.

06-189-Ax