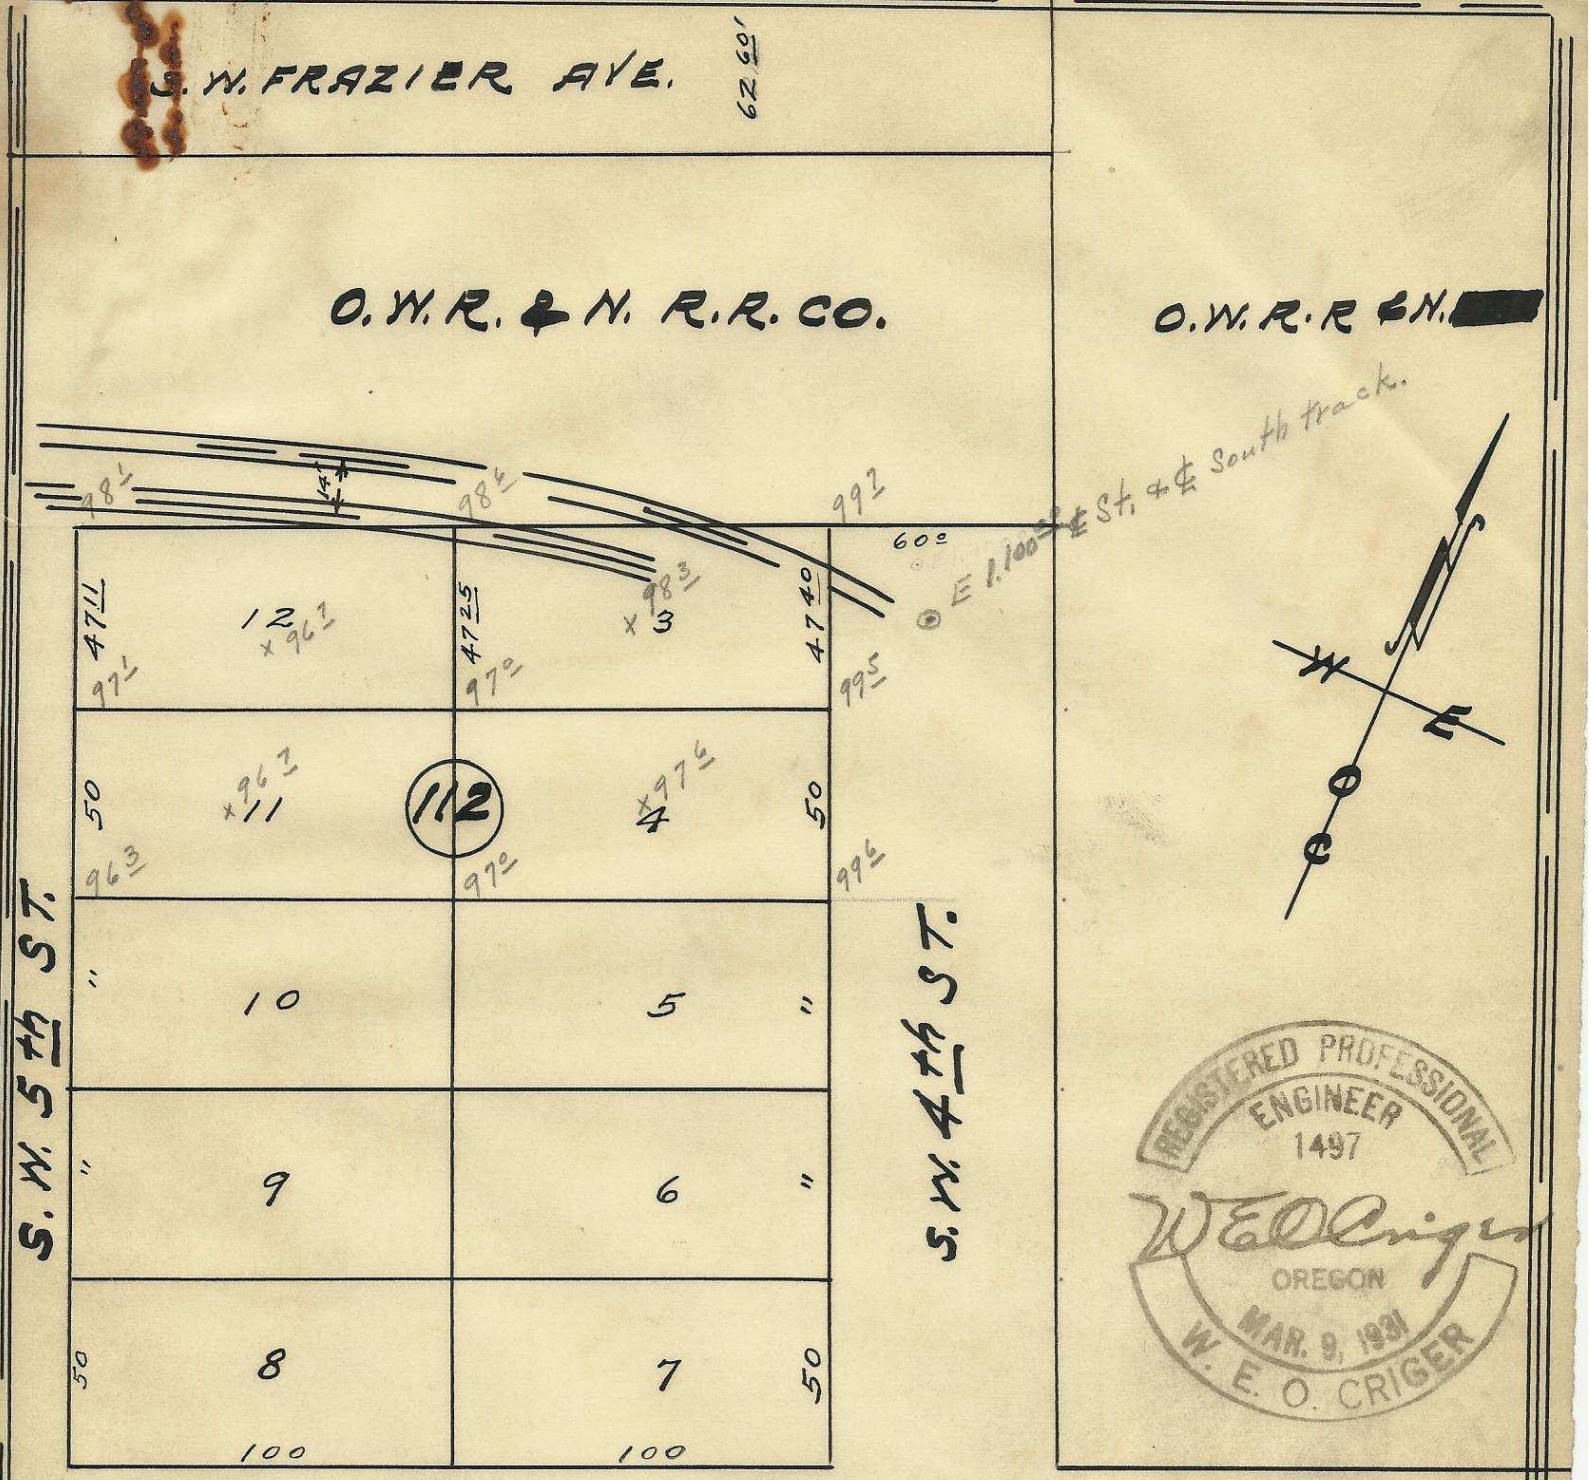

Plat of
Block 112 of Reservation
Addition to the town, now
City of Pendleton, Oregon.
Surveyed, staked & Plalled, Sept. 1948
By W.E.O. Criger-
Scale: 1 inch = 50 feet.

06-248-Ax

5