


S. W. Dorian.

M.H. 8' Deep

Valve

Fire Hydrant

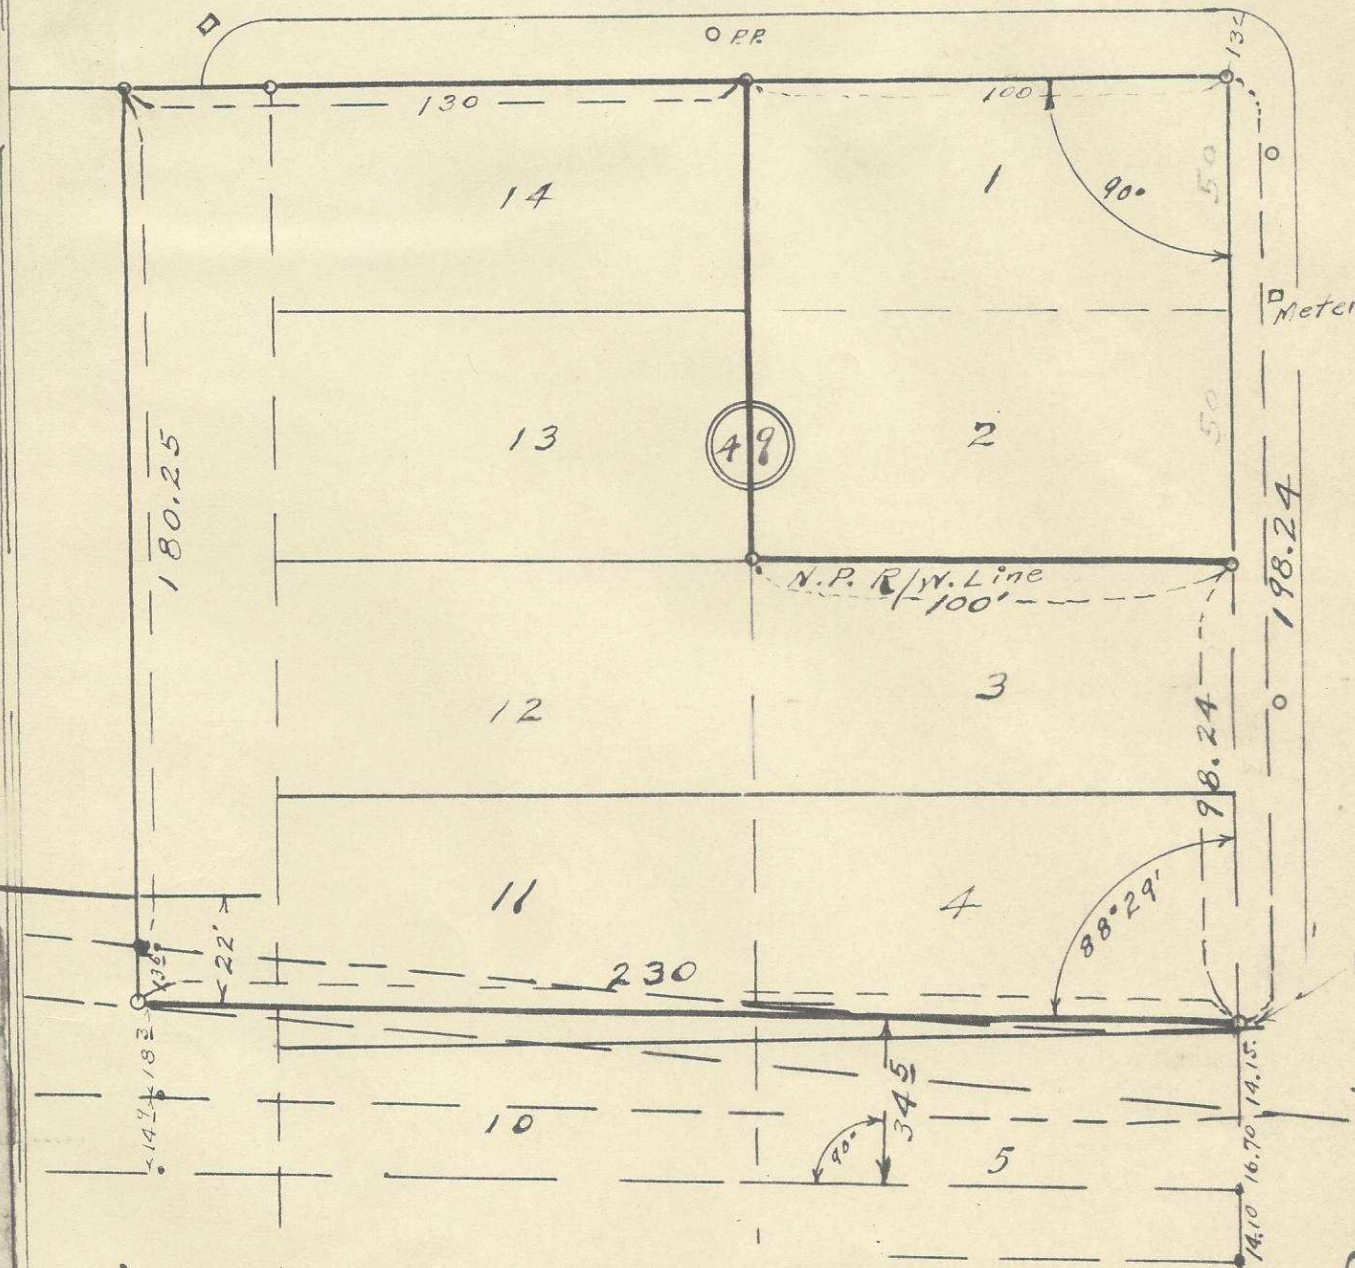

S.W. 10th St.

S.W. 11th St.
(Vacated)



2 NB 2 TO AC

Plat showing portion of Block 49 of 6 of Reservation Addition to the town, now City of Pendleton Oregon.

Surveyed, staked, + Platted
7 August - 1955
By W. E. O. Criger.

6 06-221-Ax

Scale: 1" = 40'