


Proposed Location of new Pump Station.

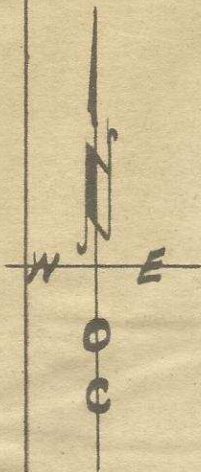

N. 44° 58' W. 2100 Ft.

County Road

County Road

23

E/4 Cor.

Road

McKay Creek


S. 36° 52' W. 3155 Ft.

Plat showing
Location of present intake
of irrigation project in E/2 of Sec. 23
T. 1 N., R. 32 E. W. M.
Surveyed - Nov. 1949 - By W. E. O. Criger
Scale = 1 inch = 400 feet.

I, W. E. O. Criger, of Pendleton, Oregon,
do hereby certify that this map was
made from notes taken during an
actual survey made by me on Nov. 15, 1949,
that the monument shown on this map
consisting of an iron pin and wooden
guard stake, at the proposed pump site,
is N. 44° 58' W. a dist. of 2100 ft. from the
E/4 Corner of Sec. 23 T. 1 N., R. 32 E. W. M.

W. E. O. Criger.

06-296-A8

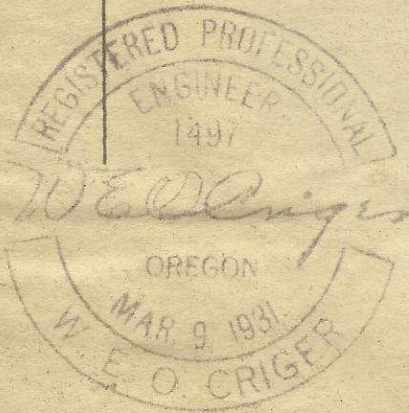

Present Point of Diversion