
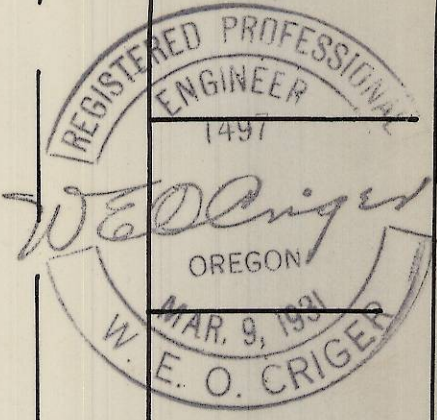


60

60

S. E. COURT N. 89° 13' E. AVE.

S. E. 19th N. 0° 47' W ST.

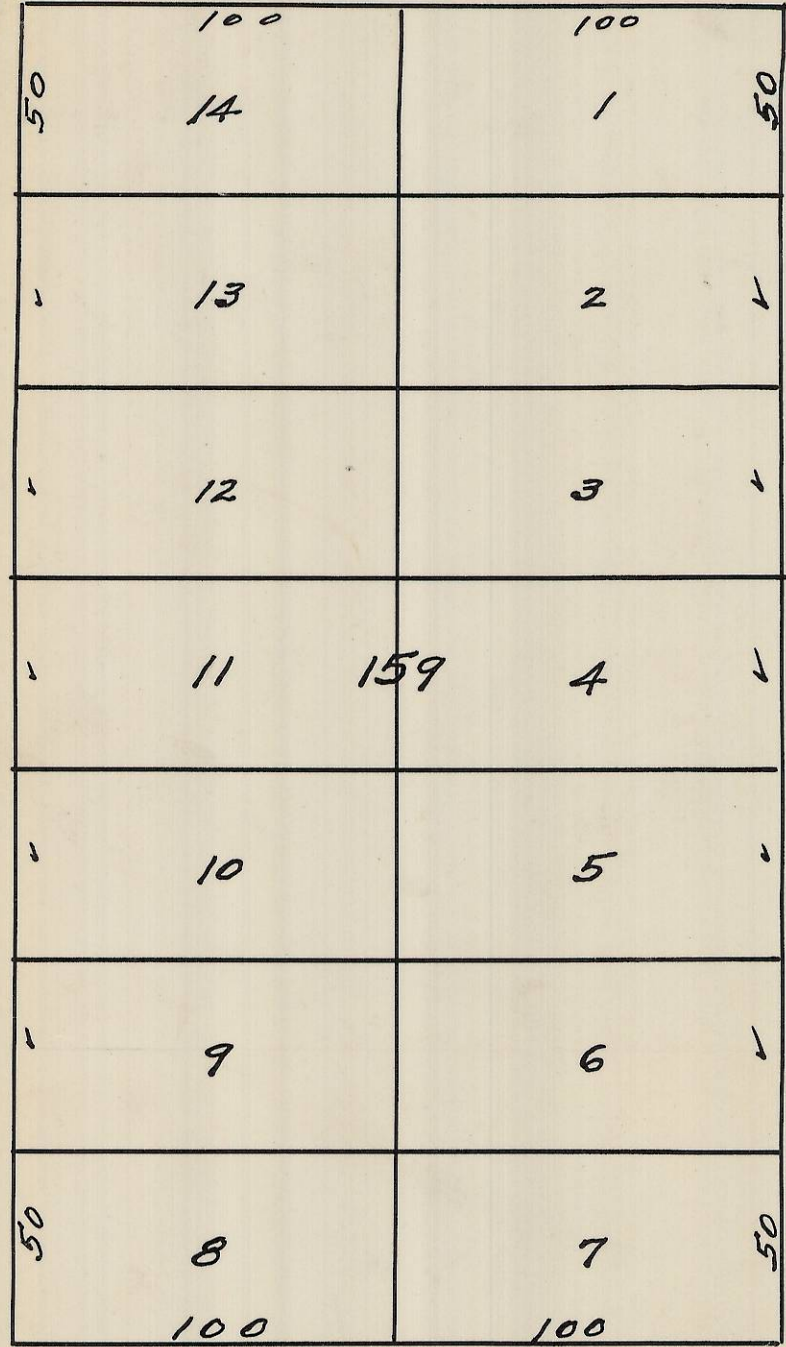

Plat showing
 Block 159 of
 Reservation Add.
 to City of Pendleton
 Oregon -
 Surveyed, staked &
 Platted - Sept. 1949
 By W. E. O. Criger
 Scale: 1" = 50'

60 S. E. 19th DRIVE

S. E. GOODWIN N. 89° 13' E. AVE.

