

Riverside Ave.

N 89° 19' W

93.00

25

Set 5/8" I. Pin

Existing fence

DUNLAP TRACT

KUMA TRACT

1/16<sup>th</sup> Line

50° 03' W - 636.57 m/l

N 0° 03' E - 636.20 m/l

SW Cor., SE 1/4, SE 1/4  
Found 5/8" I. Pin


21.68

Set 5/8" I. Pin

93.00

S 89° 32' 40" E

South Line of SE 1/4, SE 1/4

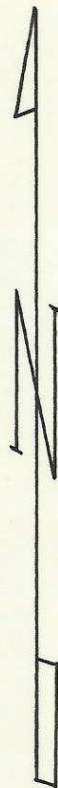

REGISTERED  
**OREGON**  
 LAND SURVEYOR

*Wayne O. Harris*  
 MAY 6, 1958  
 WAYNE O. HARRIS  
 346

WAYNE O. HARRIS & ASSOCIATES

SURVEY FOR

TED SMITH ET AL  
 PARCEL IN  
 SE 1/4, SE 1/4 SECTION 1  
 T. 2 N., R. 32 E., W.M.

SCALE	DATE	DRN. BY	DRNG. NO.
1"=80'	12-27-68	EKO	68-284

F-8-A x