


15 14  
1/4 Cor. End.

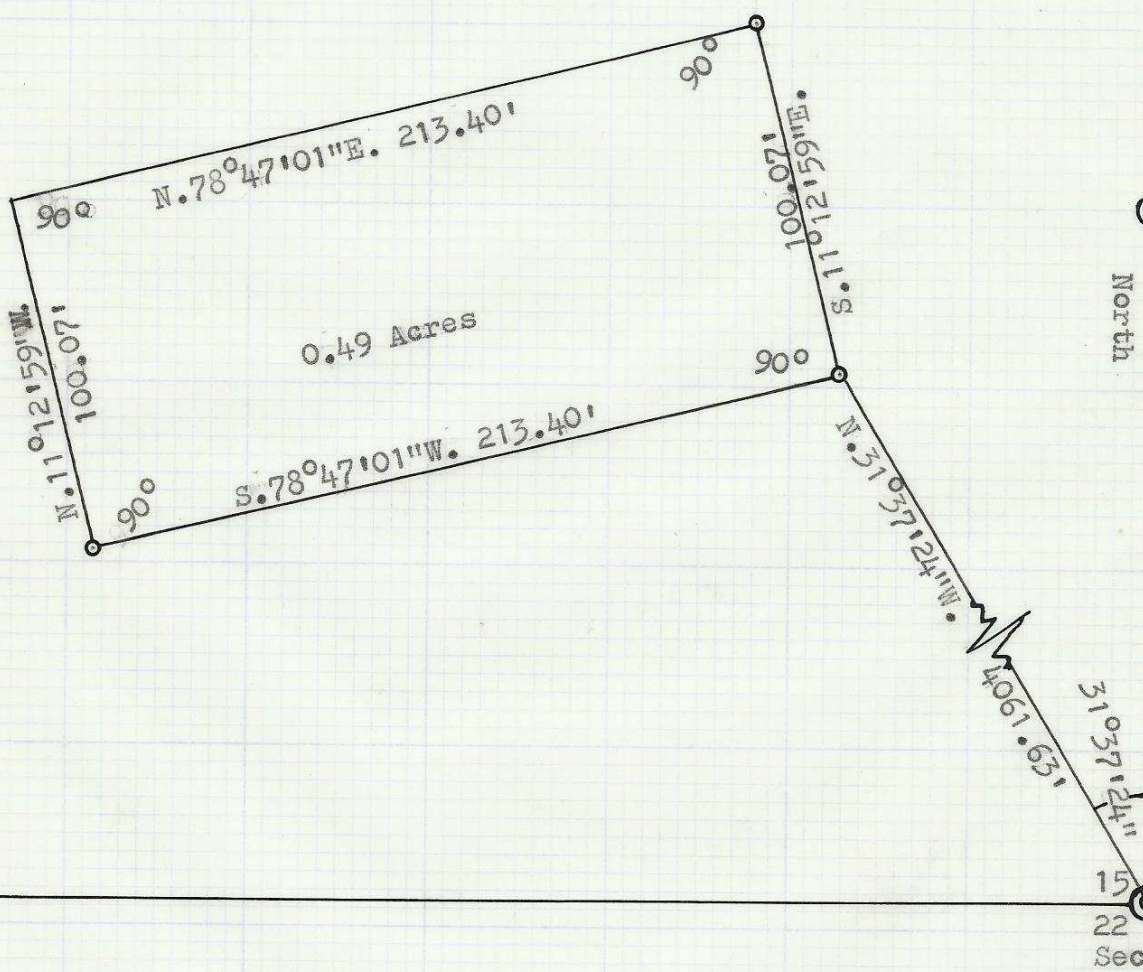

1/16 Cor. End.

North

15 14  
22 23  
Sec. Cor. End.

REGISTERED  
OREGON  
LAND SURVEYOR

*Ralph P. Thompson*

MAY 13, 1960  
RALPH P. THOMPSON  
506

Property Survey For  
Lyle Ledbetter  
Cayuse, Oregon  
In Sec. 15, T. 2 N. R. 34 EWM

Date: 4/14/71 Scale: 1"=50'

**RALPH THOMPSON**  
REGISTERED LAND SURVEYOR  
P.O. BOX 1082 PENDLETON, ORE. 97806  
*H-6*  
*H-6-Ax*

Basis of bearings was taken from the east line of sec. 15 as north.

- Indicates 1/2"x24" I.P. Set
- ⊙ Indicates standard Indian allotment Brass cap found.