


H-54-Ax

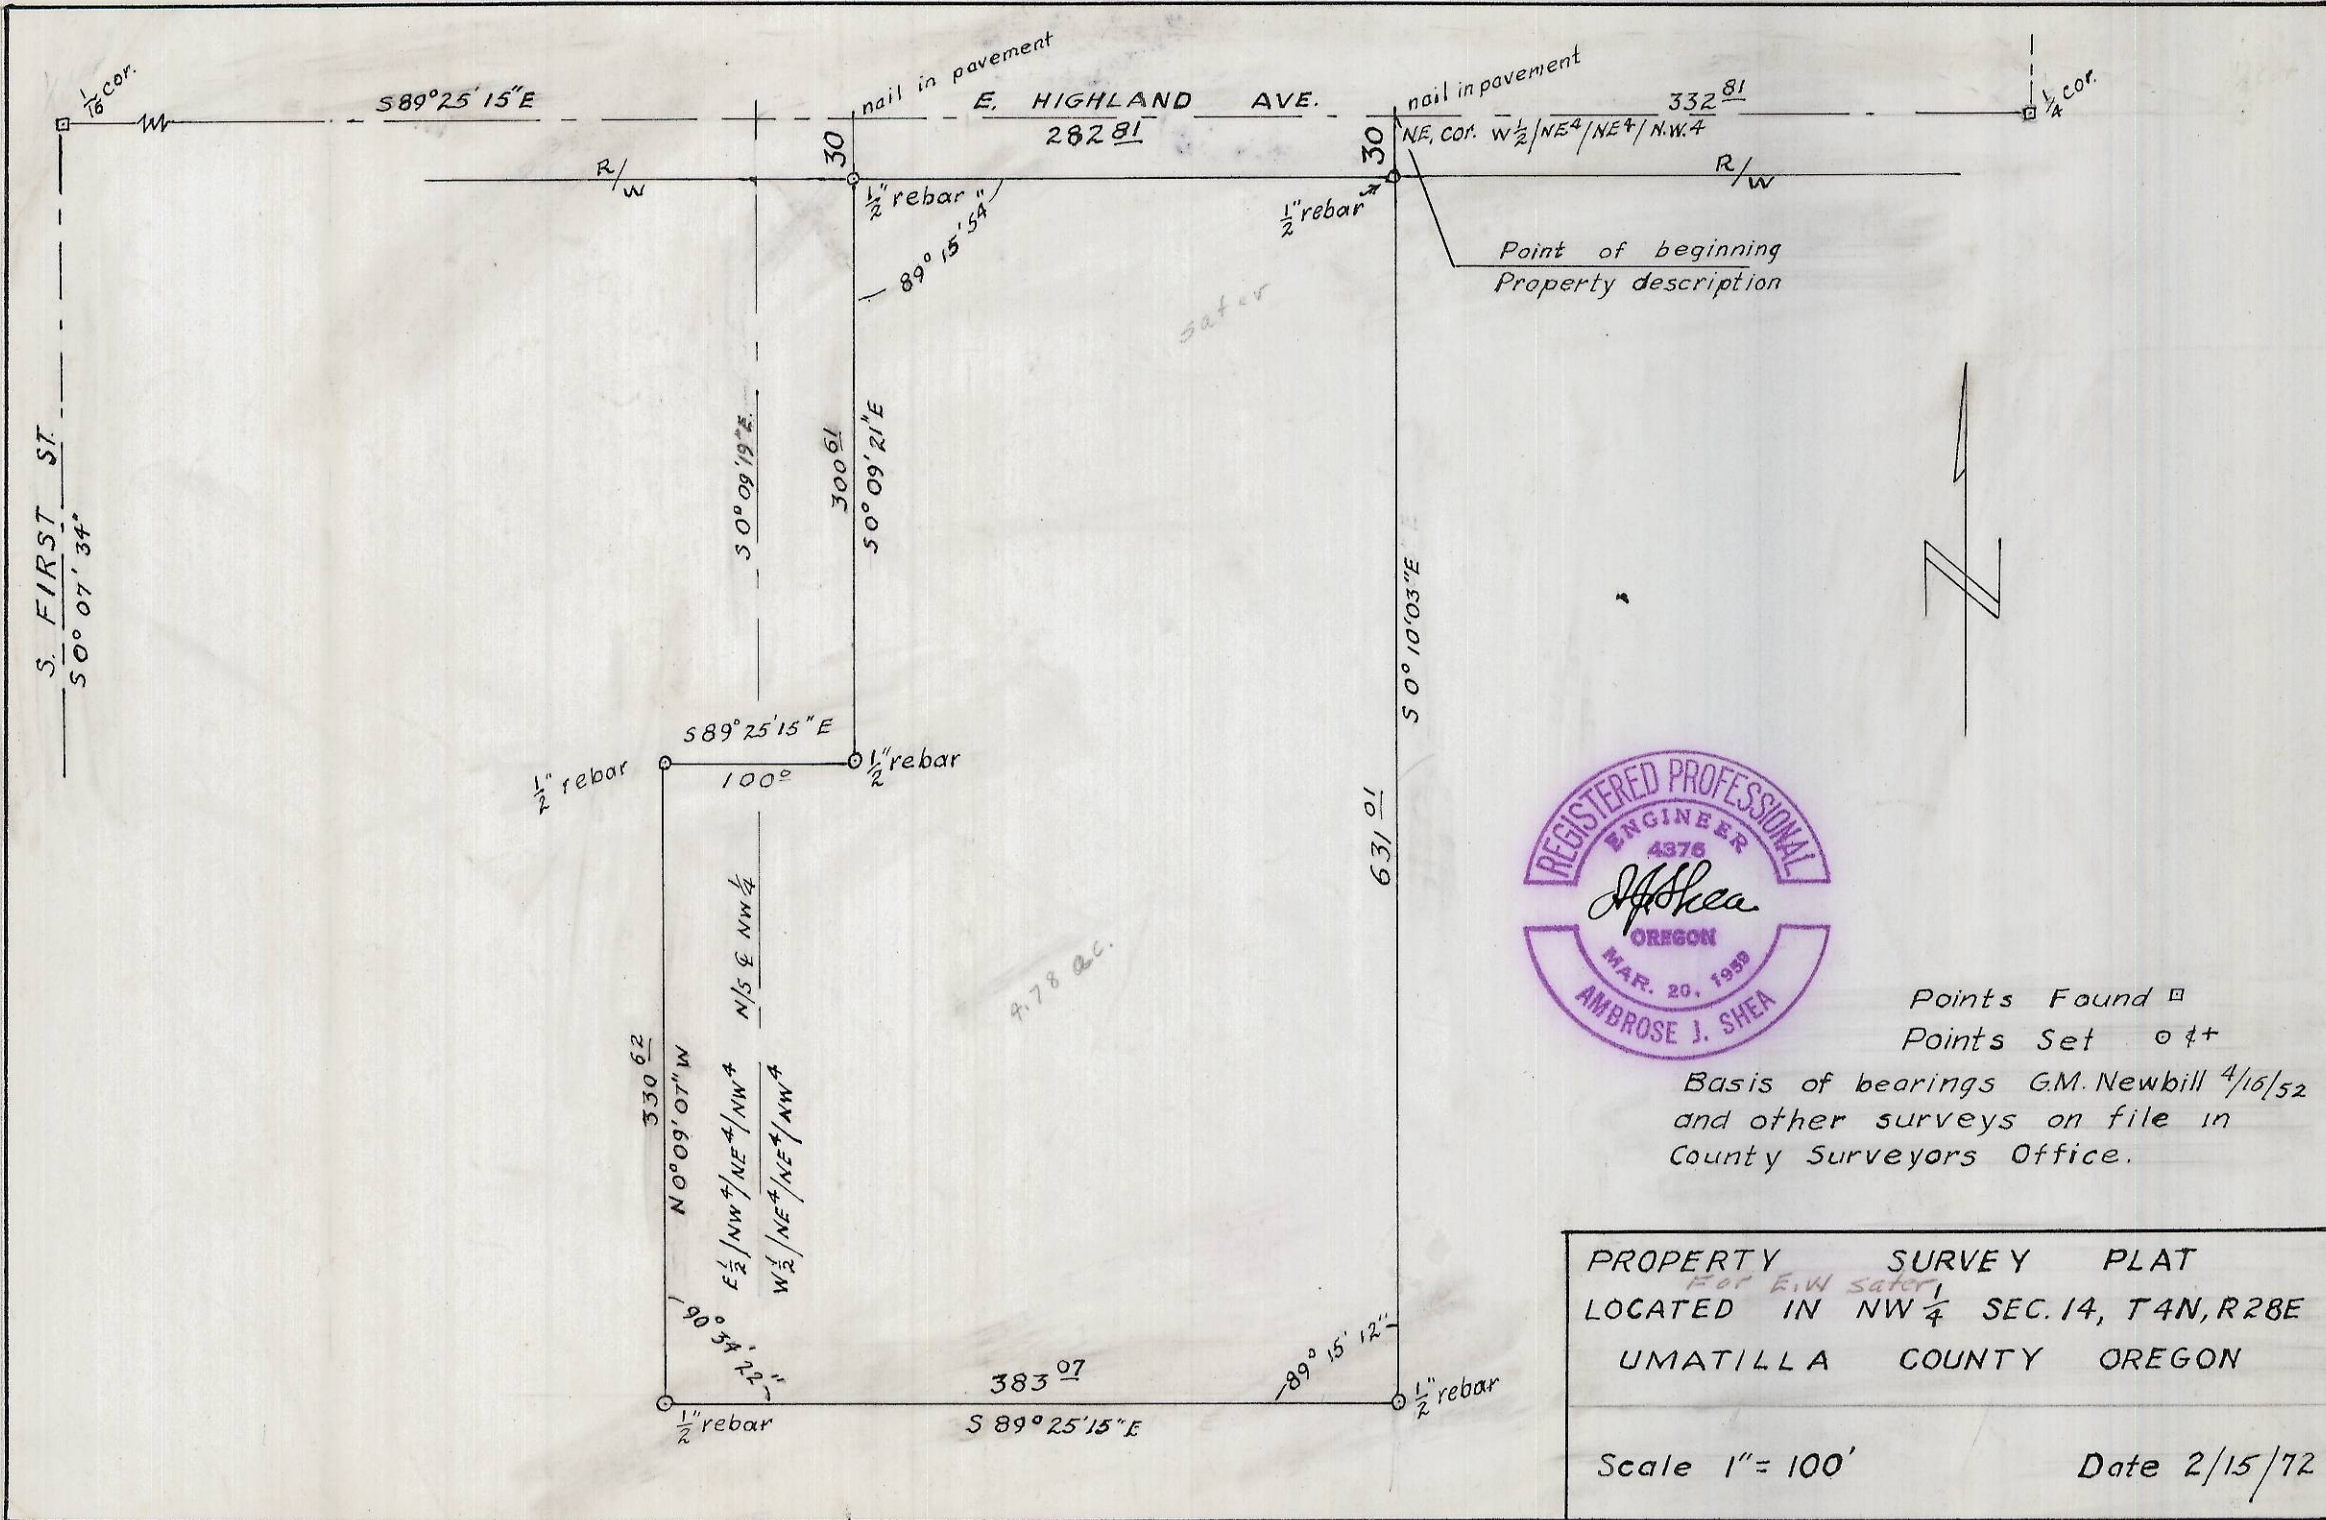

H-54