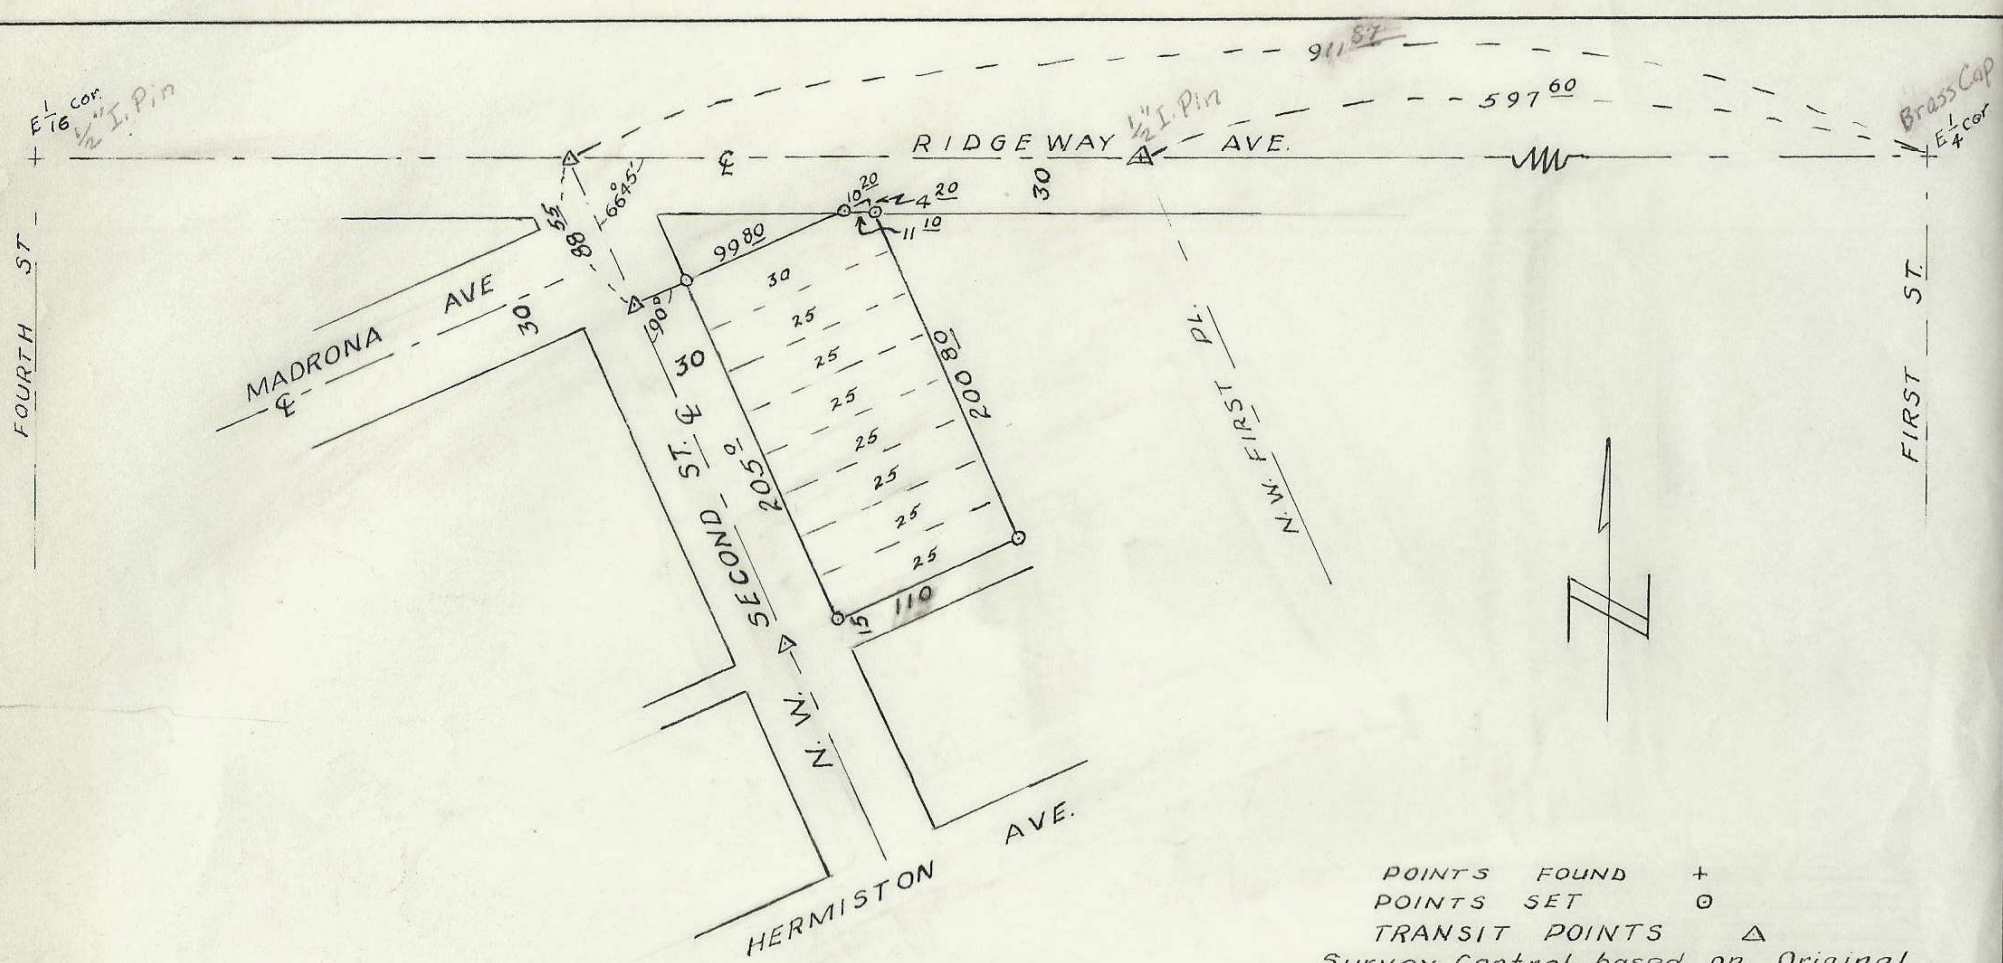

POINTS FOUND +
POINTS SET ⊙
TRANSIT POINTS △
Survey Control based on Original Survey of Hermiston Town dated April 1905 on file in City Hall, Hermiston.

REGISTERED PROFESSIONAL ENGINEER 4376 A. J. Shea OREGON MAR. 20, 1959 AMBROSE J. SHEA

NE¼ SE¼ 10-4N-28E

SURVEY PLAT

BLOCK 1 LOTS 10 thru 17
For Fraternal Order of Eagles
ORIGINAL TOWN HERMISTON
UMATILLA COUNTY OREGON
Scale 1" = 100' Date 4-7-72

H-62