H-2354x

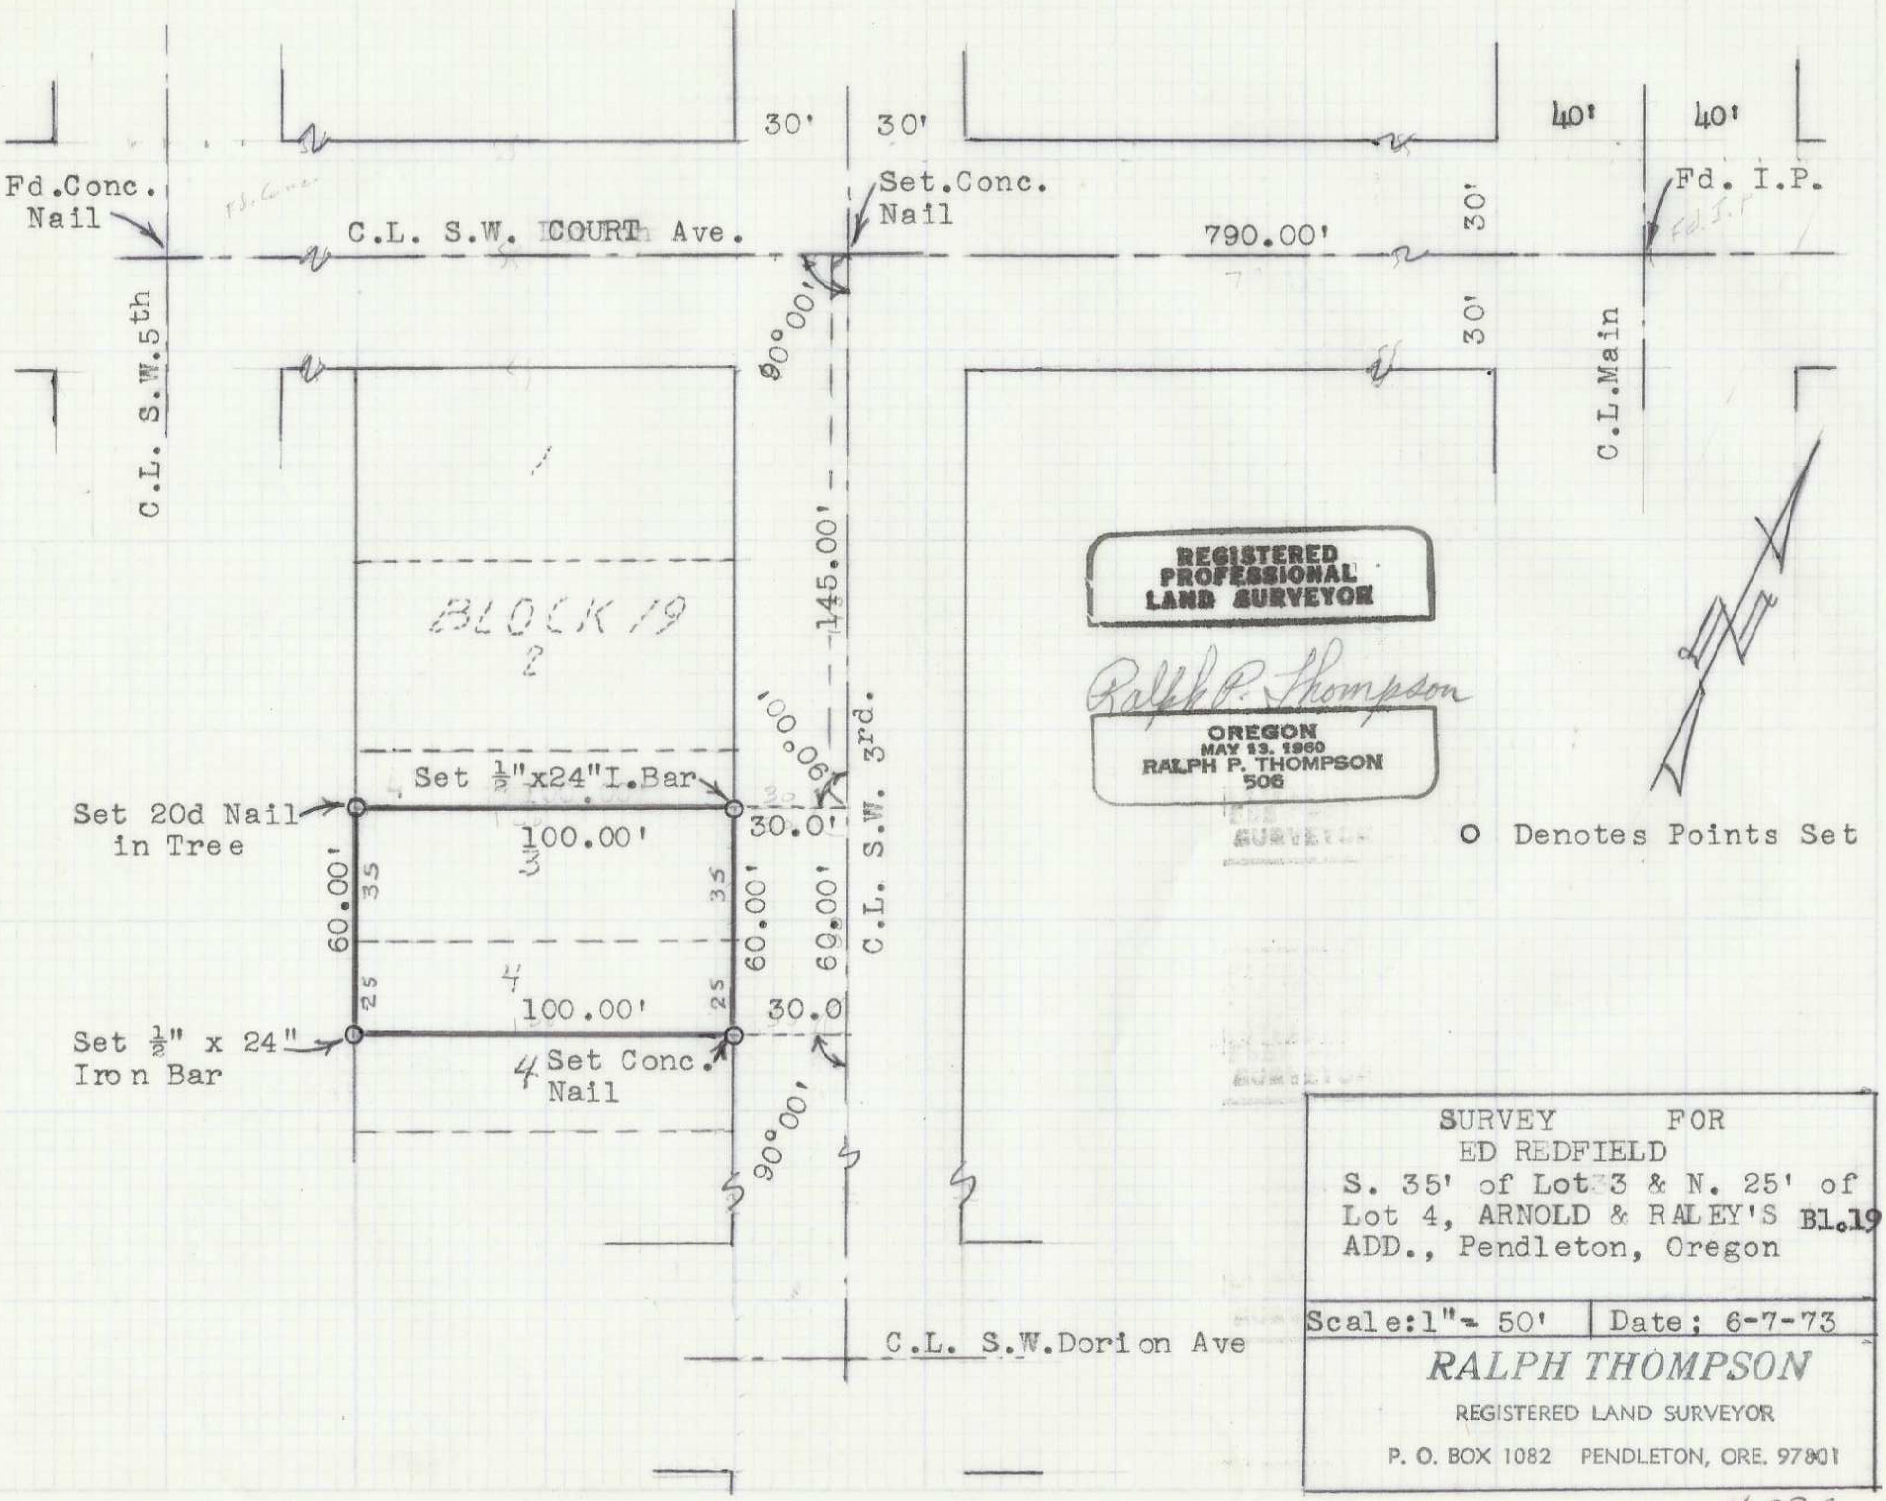

SURVEY FOR
ED REDFIELD
S. 35' of Lot 3 & N. 25' of Lot 4, ARNOLD & RALEY'S Bl.19 ADD., Pendleton, Oregon

Scale: 1" = 50'	Date: 6-7-73

RALPH THOMPSON
REGISTERED LAND SURVEYOR
P. O. BOX 1082 PENDLETON, ORE. 97801

H-235