


H-247-Ax

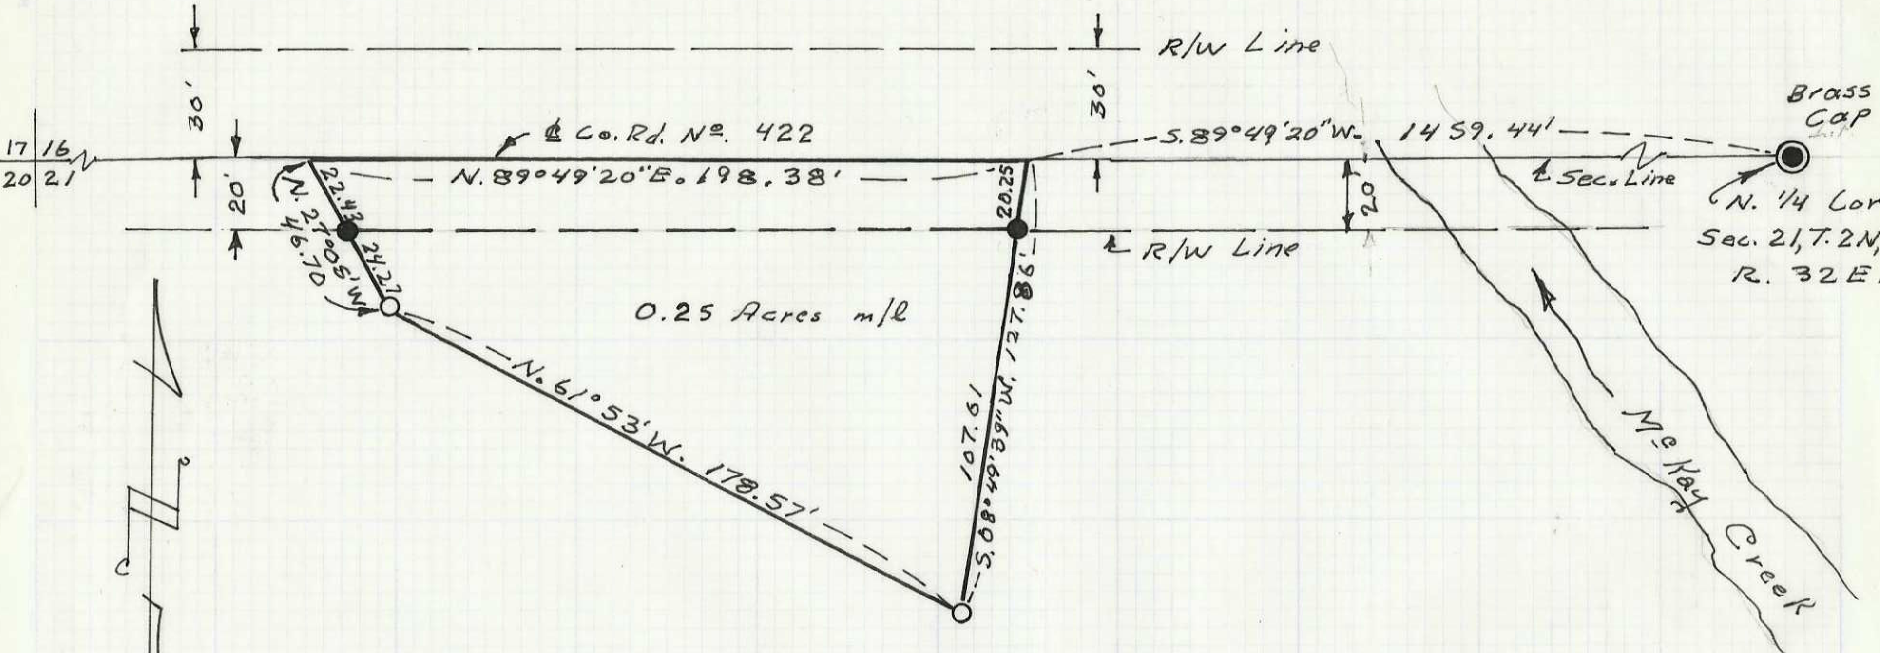

- Iron Pins Found.
- 1/2" x 24" Iron Pins Set.
- ⊙ Monument Found

NOTE: Bearings based on North Line of Section being N. 89°49'20"E.

REGISTERED PROFESSIONAL LAND SURVEYOR

*Ralph P. Thompson*

OREGON  
MAY 22 1968  
RALPH P. THOMPSON  
506

SURVEY FOR  
**DON BRADBURY**  
IN THE N.W. 1/4 OF  
SEC. 21, T. 2N. R. 32E.  
Scale: 1" = 50' | Date: 11-8-73

**RALPH THOMPSON**  
REGISTERED LAND SURVEYOR  
P.O. BOX 1082 PENDLETON, ORE. 97801

H-247