
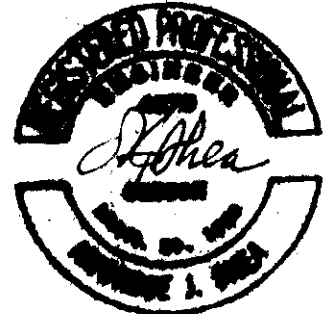


I-69-Ax

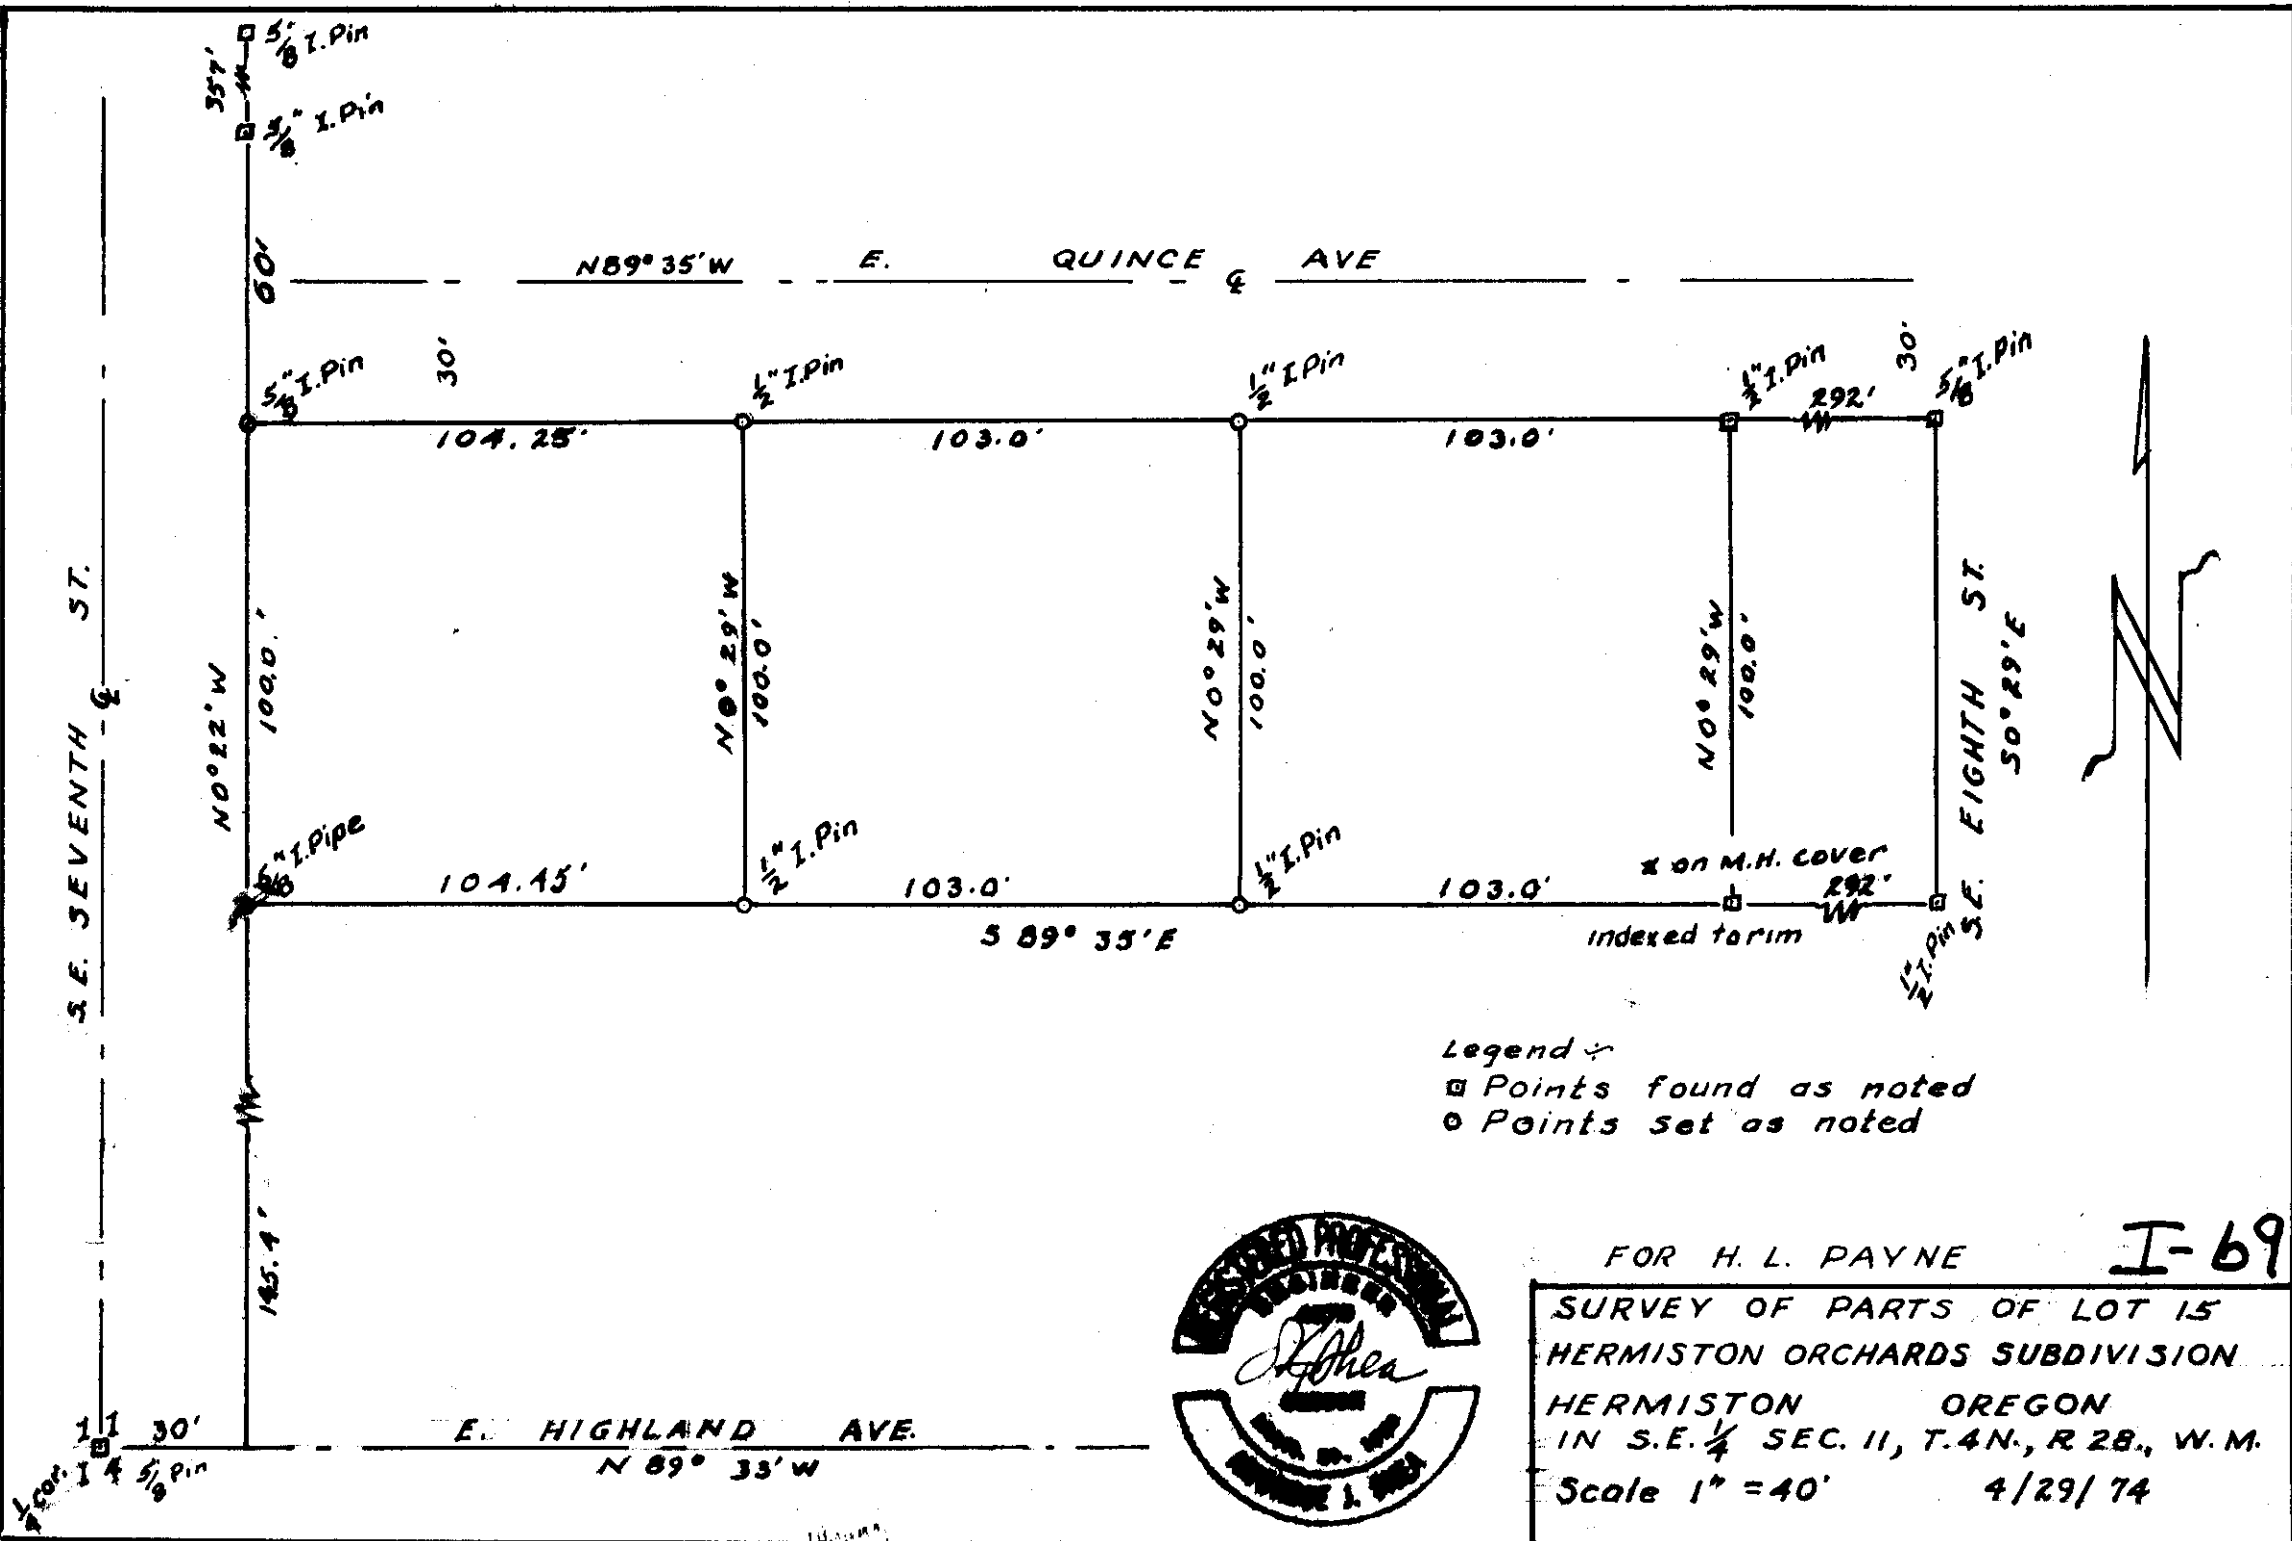

I-69