


J-145-Ax

FD. 3/4" I. PIPE - S. 1/16 C-C

DUNNE STREET R/W LINE


SCALE: 1" = 50'

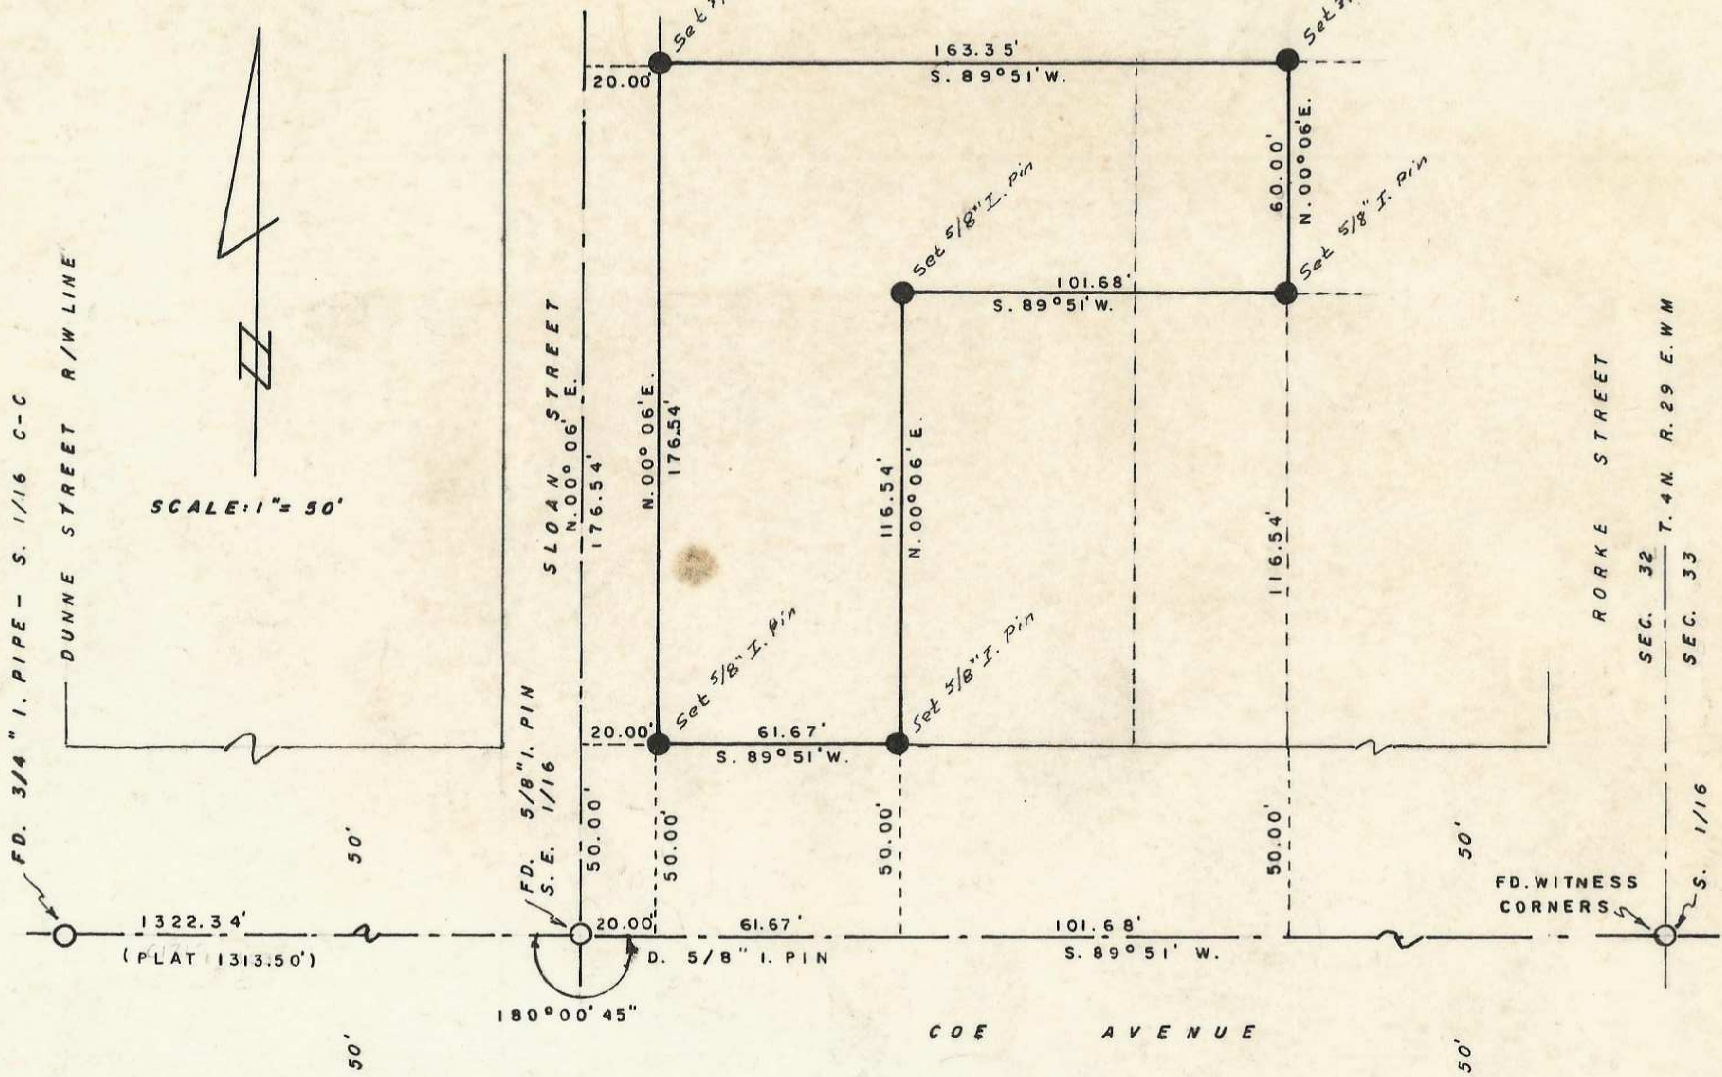

SLOAN STREET
N. 00° 06' E.
176.54'

RORKE STREET
SEC. 32 T. 4N. R. 29 E. W.M.
SEC. 33

COE AVENUE

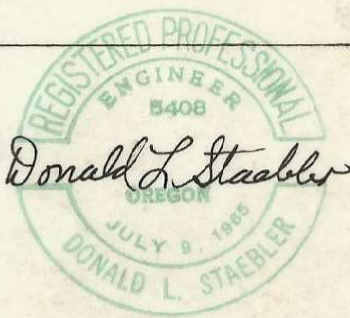

Donald L. Staebler

Based on Fraley's Survey

SURVEY FOR LESTER LIPPERT IN THE N.E. 1/4 OF THE S.E. 1/4 OF SECTION 32, T. 4N. R. 29 E.W.M.	
SCALE: 1" = 50'	DATE: 4/28/75
DONALD L. STAEBLER CONSULTING ENGINEER P.O. BOX 91	
PENDLETON OREGON 97801	

J-145