

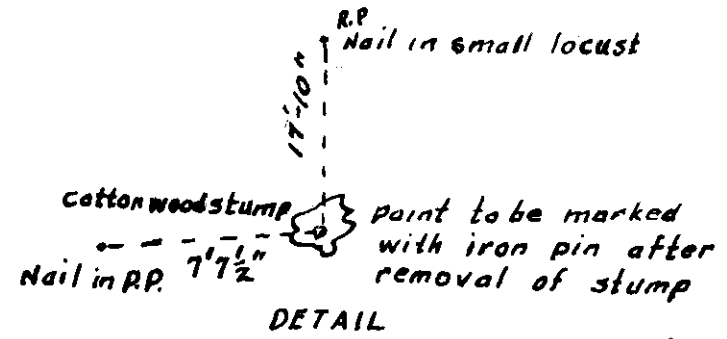


X-1-Ax

N 1/2 Sec. 6 T4N, R29E

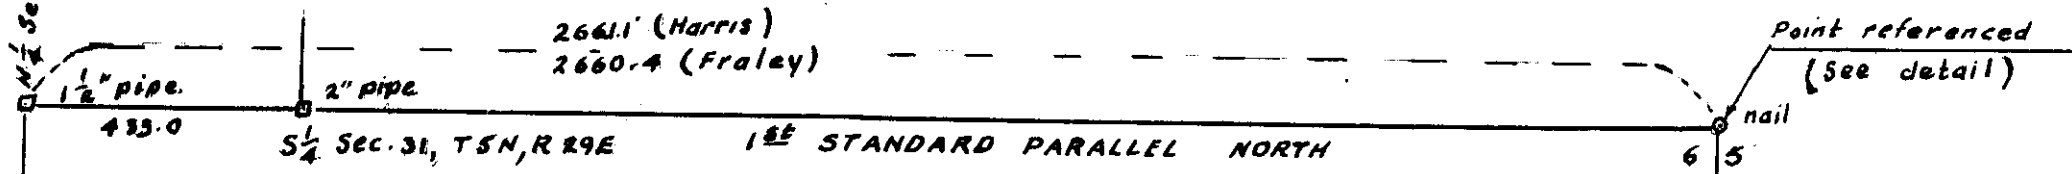

LEGEND  
 □ Points Found as described  
 ○ Points set as described

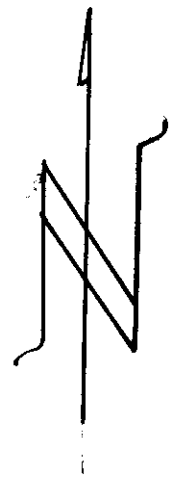

REESTABLISHMENT OF N.E. CORNER  
 SEC. 6, T4N, R. 29E. W.M.  
 FOR M.C. NOE  
 SCALE 1" = 300'  
 12-2-75

K-1