


LEGEND  
 □ POINTS FOUND  
 ○ POINTS SET  
 BEARINGS BASED ON 1906 G.L.O. SURVEY  
 OF SEC. 32 & LOTTING OF S.W. 1/4 OF SAME

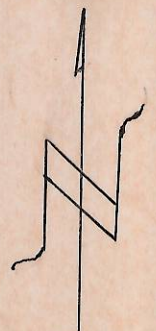

L-1  
 FOR I. W. BORKOVIC  
 PROPERTY SURVEY PLAT  
 TRACT IN S.E. 1/4 SEC. 31, T5N, R29E, W.M.  
 UMATILLA CO. ORE.  
 SCALE 1" = 200' 7-2-76

L-1-A