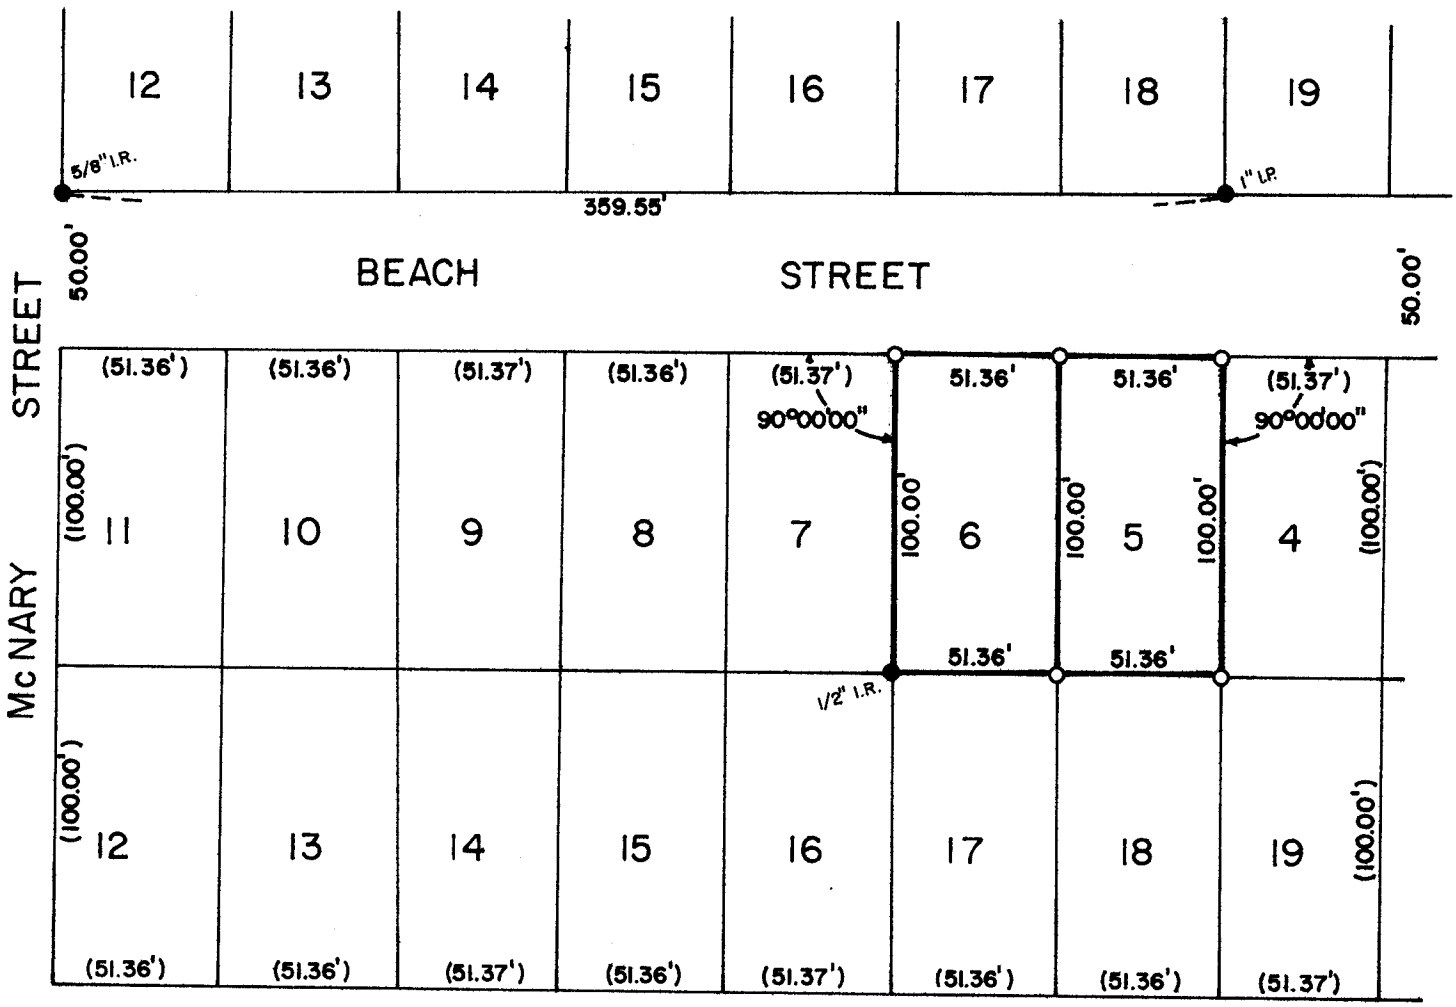

M-060-AX

REGISTERED PROFESSIONAL LAND SURVEYOR

G. Dennis Edwards

OREGON
JULY 16, 1971
G DENNIS EDWARDS
951

SURVEY FOR SIMPLEX

LOCATION MORNINGSIDE TRACTS, LOTS 5 & 6, BLOCK E, SEC. 11, T 4 N, R 28 E, W.M., UMATILLA COUNTY, OREGON

DATE: 2-23-77

SCALE: 1" = 60'

● MONUMENTS FOUND

(000) OF RECORD

o 1/2" IRON RODS SET

JOB NO. S7702046

EDWARDS SURVEYING
567-3336

P. O. Box 763
Hermiston, Ore.