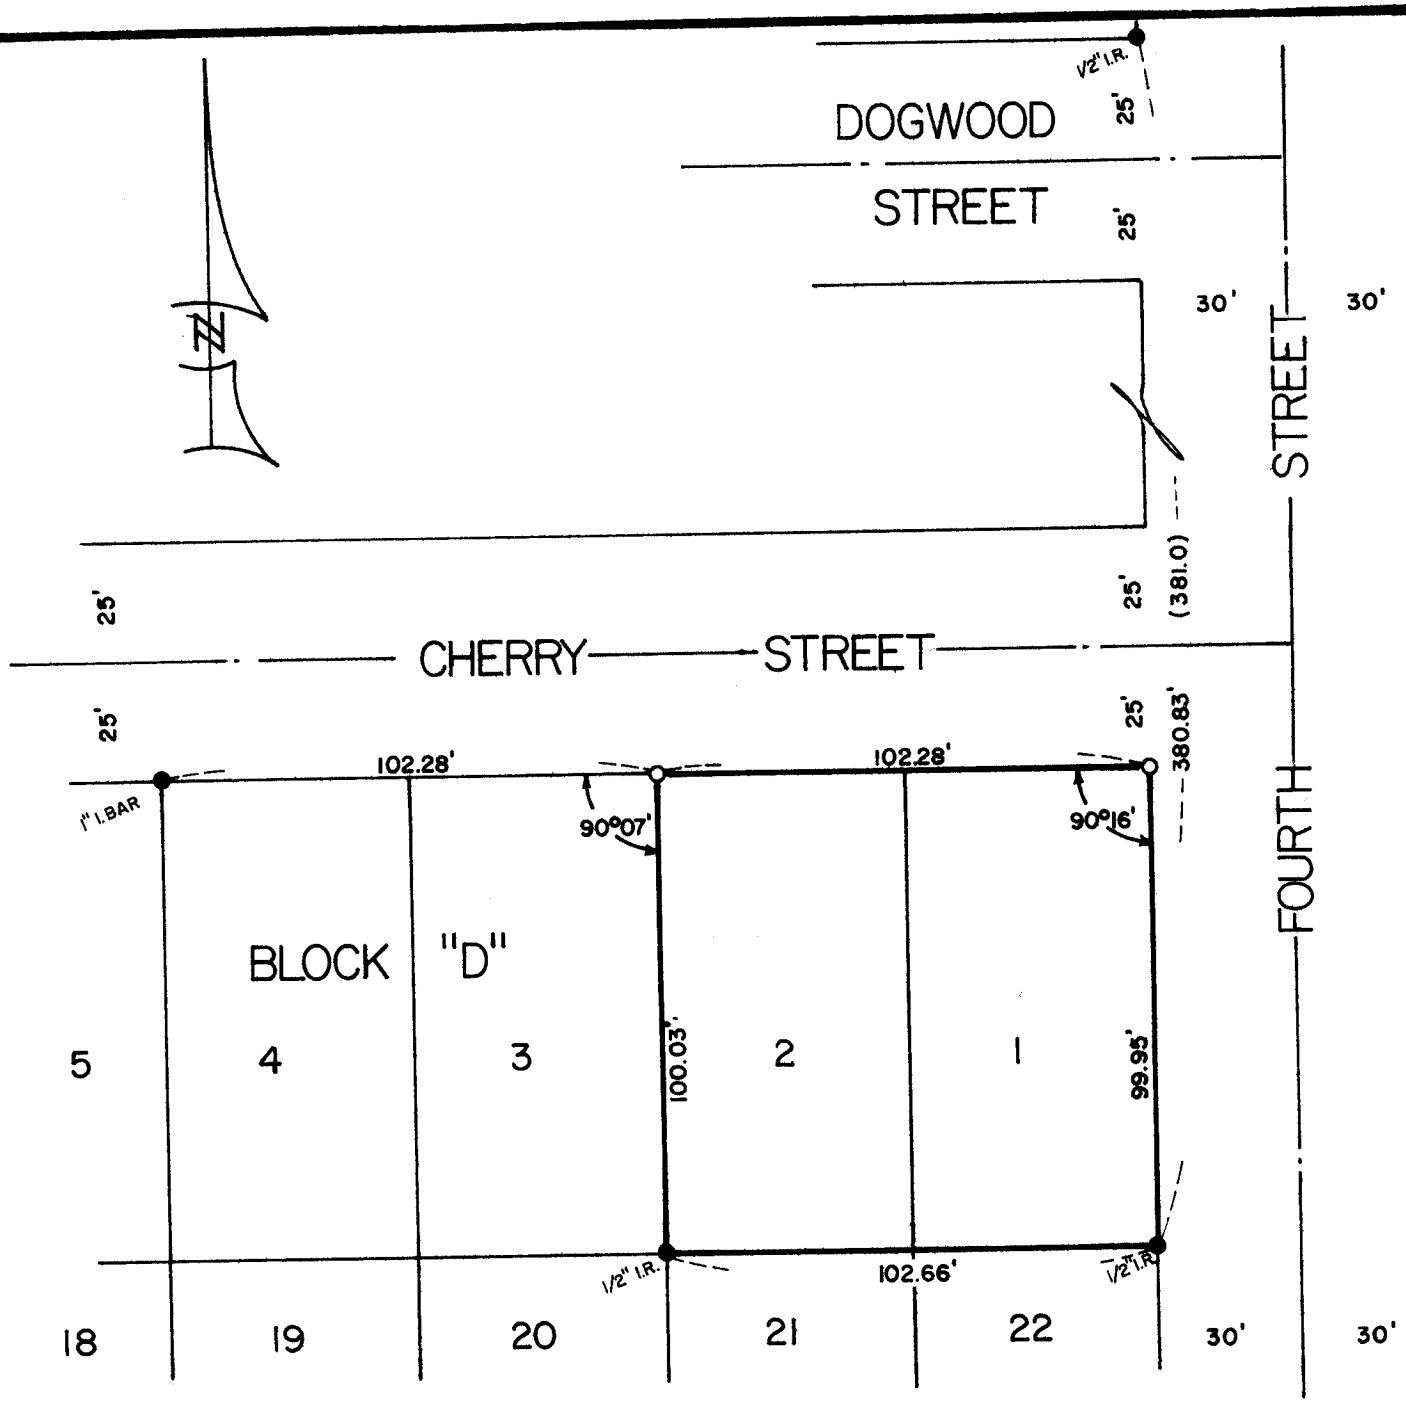

SURVEY FOR: VERNON WHEELER

LOCATION: MORNINGSIDE TRACTS, AN ADDITION TO THE CITY OF HERMISTON, IN THE NW 1/4 OF THE NW 1/4 OF SEC. 11, T 4 N, R 28 E W.M., UMATILLA COUNTY, OREGON

DATE: 5-28-77

SCALE: 1" = 40'

● MONUMENTS FOUND

(000) OF RECORD

o 1/2" IRON RODS SET

JOB NO. S7703071A

REGISTERED PROFESSIONAL LAND SURVEYOR

G. Dennis Edwards

OREGON
JULY 16, 1971
G. DENNIS EDWARDS
951

N-001-AX

EDWARDS SURVEYING
567-3336

P. O. Box 763
Hermiston, Ore.