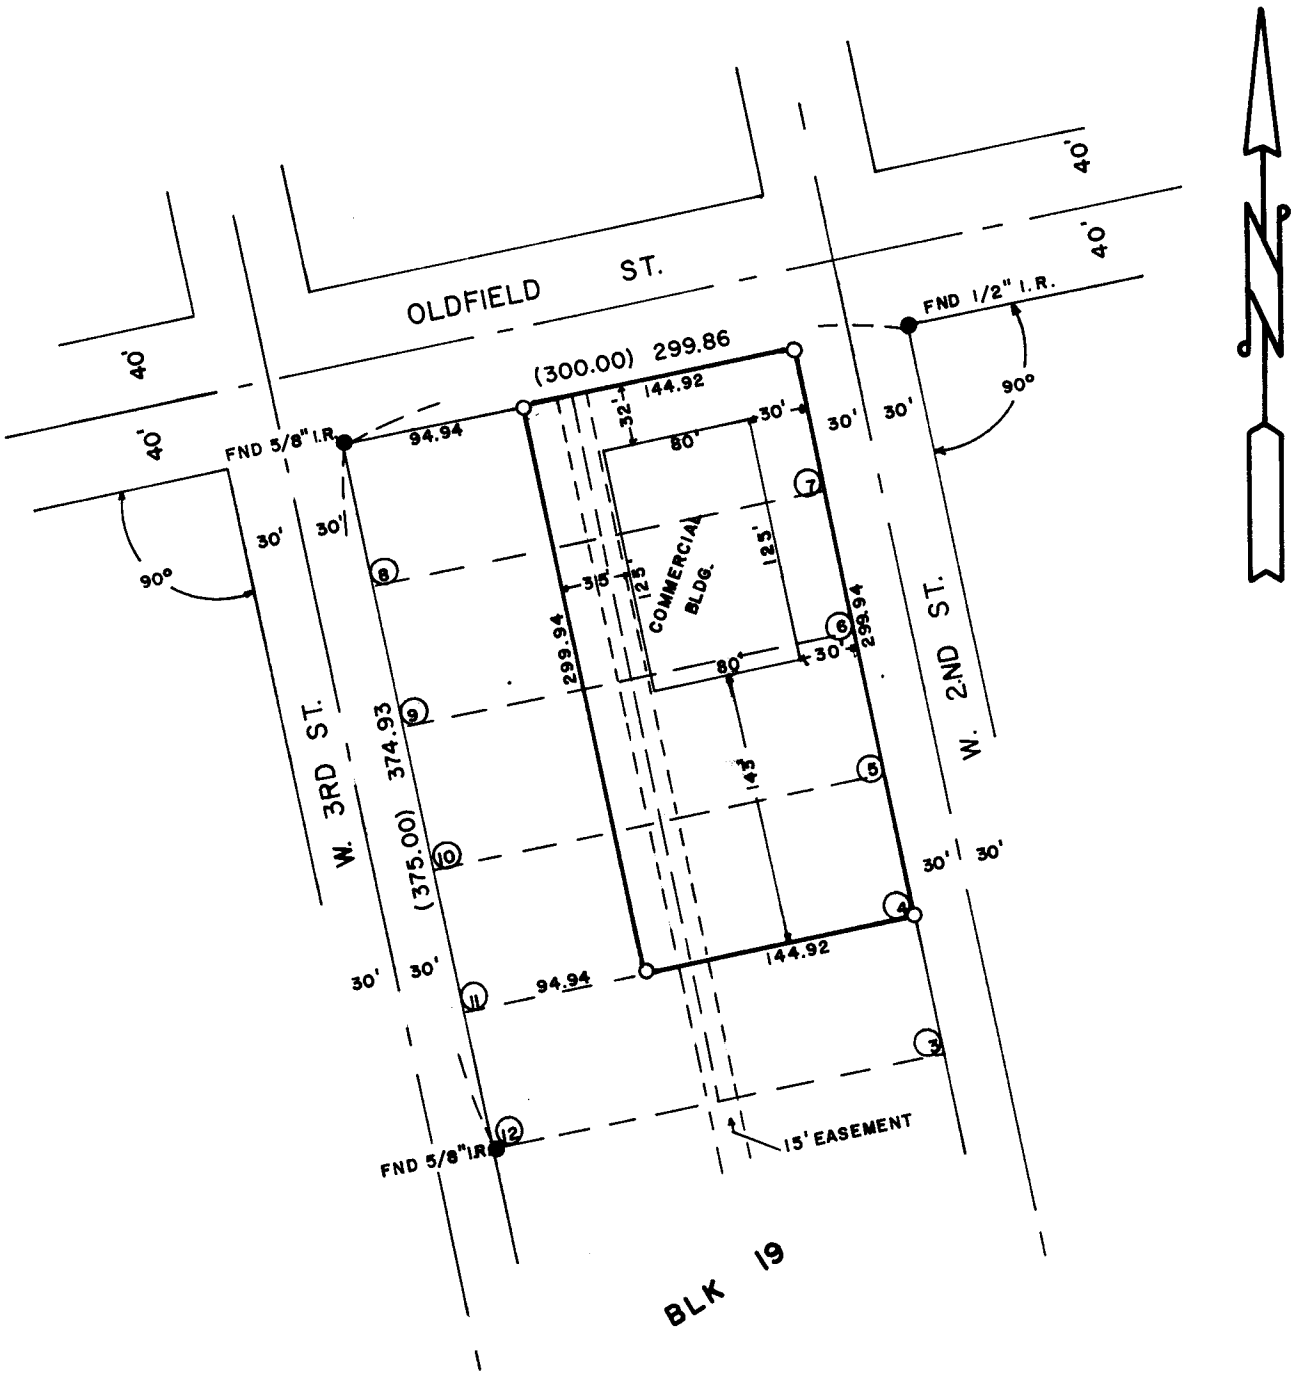

REGISTERED PROFESSIONAL LAND SURVEYOR

G. Dennis Edwards

OREGON
JULY 16, 1971
G. DENNIS EDWARDS
951

P-002-AX

SURVEY FOR GARY HUGHES

LOCATION BLK 19, CHARLES TRACTS, IN

SEC. 27, T5N, R28E, W.M. UMATILLA CO. ORE.

DATE 2-20-78 JOB NO. S7802052

●MONUMENTS FND ○IRON RODS SET 1/2"

SCALE 1" = 100'

EDWARDS SURVEYING P.O. BOX 763

567-3336 HERMISTON, ORE.