


LOCATED IN BLOCK "B" THORP ADD. TO HERMISTON  
 S.W. 1/4 SEC 10 T4N R28 E.W.M. UMATILLA CO. ORE.  
 LOTS 5 & 6

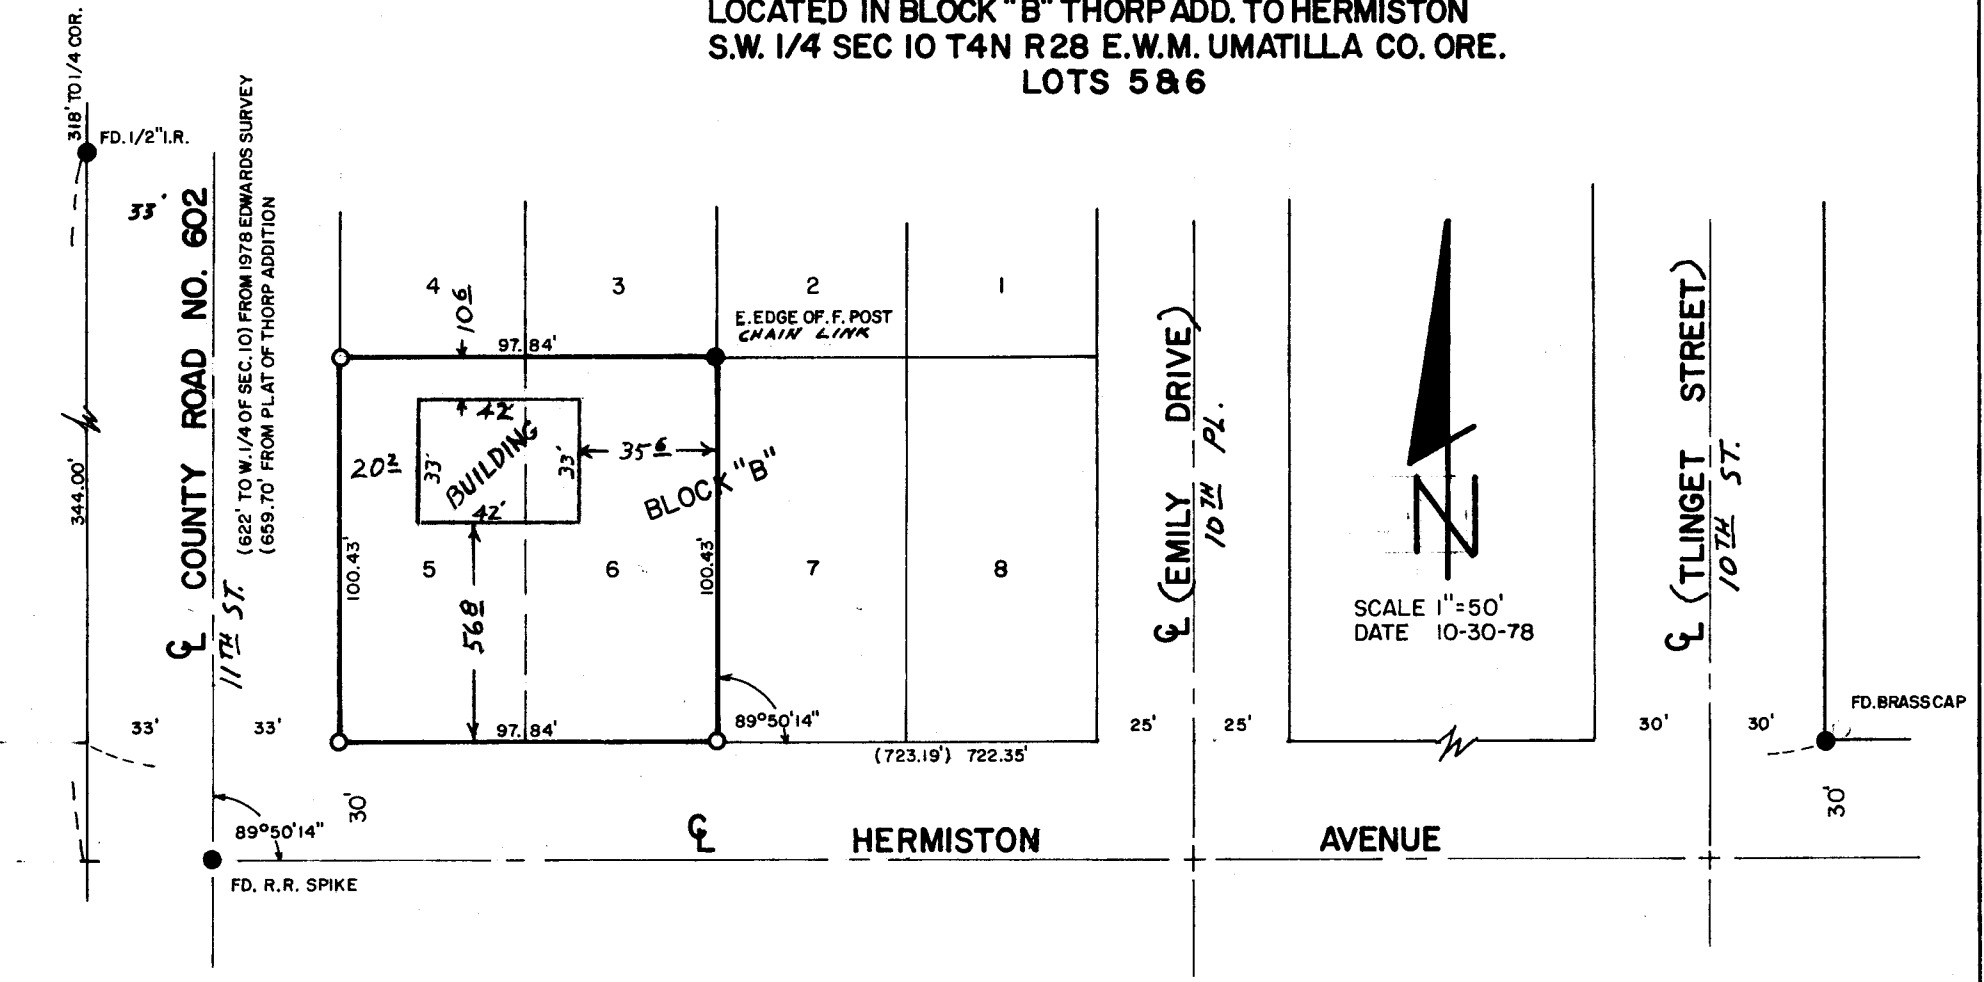

**REGISTERED  
 PROFESSIONAL  
 LAND SURVEYOR**

*G. Dennis Edwards*

**OREGON**  
 JULY 16, 1971  
**G. DENNIS EDWARDS**  
 951

**SURVEY FOR: KEN SJOREN**

LEGEND:  
 MONUMENTS FOUND ●  
 1/2" IRON RODS SET ○  
 (OOO) OF RECORD

JOB NO. 7810380

10/30/78

**EDWARDS SURVEYING**

PH. 567-3336  
 P.O. BOX 763  
 HERMISTON, ORE.

P-116-AX