


BLOCK 7

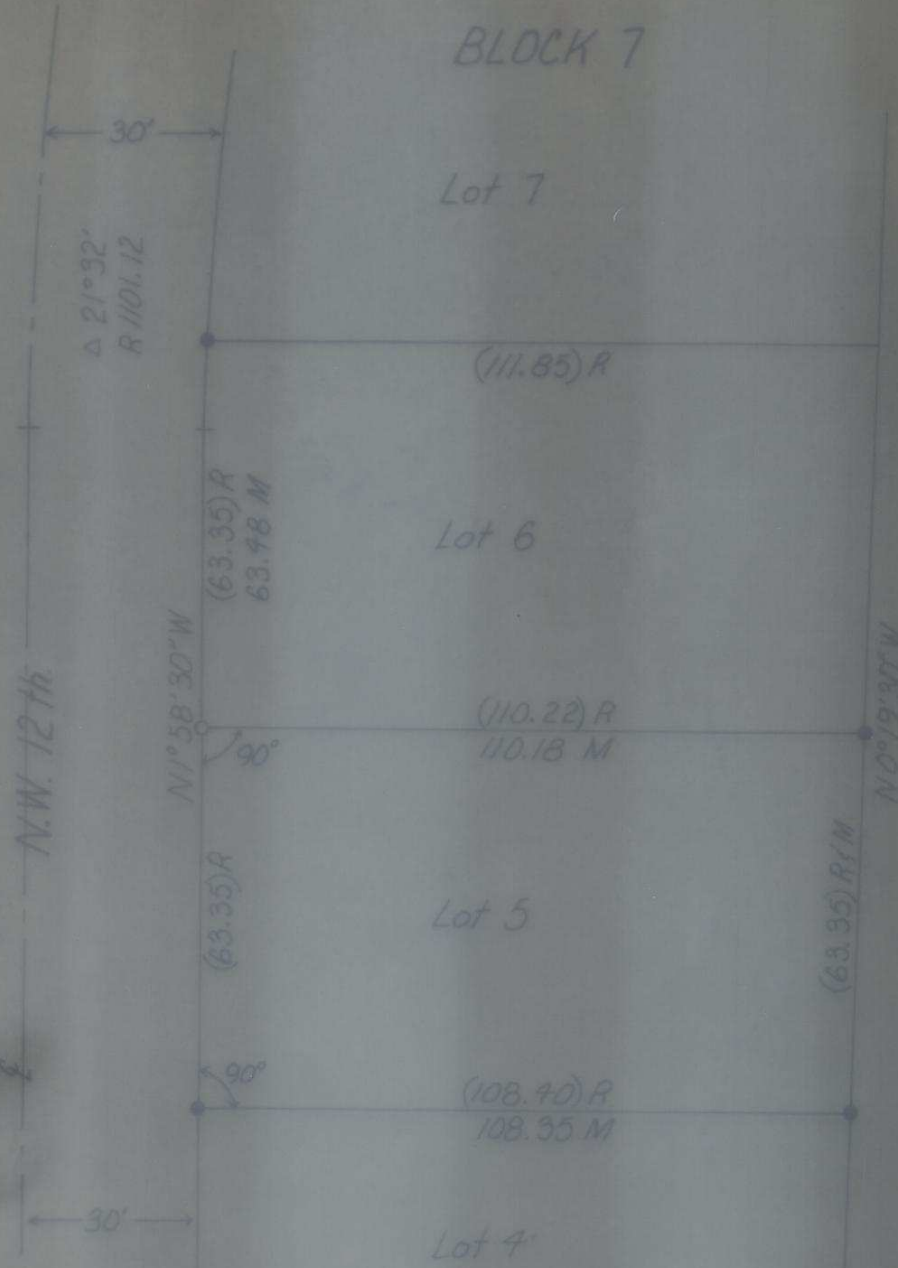

REGISTERED
PROFESSIONAL
LAND SURVEYOR

David H. Krumben

OREGON
JULY 27, 1978
DAVID H. KRUMBEIN
533

LEGEND:

- () denotes Recorded Distances
- denotes found 1/2 in. pin
- denotes set 1/2 in. pin

 <p>KRUMBEIN ENGINEERING CO. ENGINEERS - SURVEYORS - PLANNERS 221 S. Main, Pendleton, Oregon</p>	SCALE 1" = 30'
	DATE Nov. 20, 1978
	DRN BY R.I.J.
	CKD BY D.H.K.
<p>Survey for SID THOMPSON</p> <p>Lots 4-7, Blk. 7, West Hills, Pendleton, Oregon</p>	
<p>DRNG NO. 78-102A</p>	

Job No. 78-262