
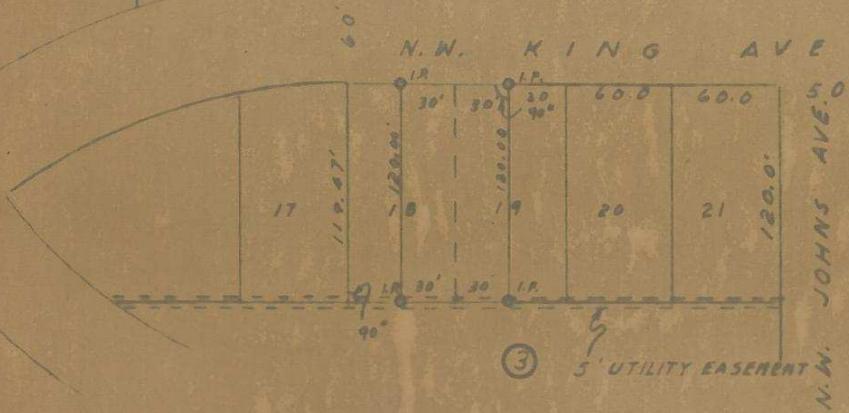


Q-155-71

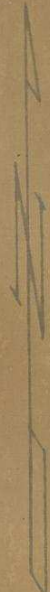

Wayne O Harris

NE4SW4 (3)

HAYES AND HARRIS

Survey For

PENDLETON HOUSING CORPORATION

E. 1/2 Lot 18 & W. 1/2 Lot 19

Block 3

399

West Hills Add'n, Pendleton, Ore.

Scale	Date	Drn. By	Drng. No.
1"-100'	10/30/58	WOH	58-70

Q-155-HX