


Q-188-Ax

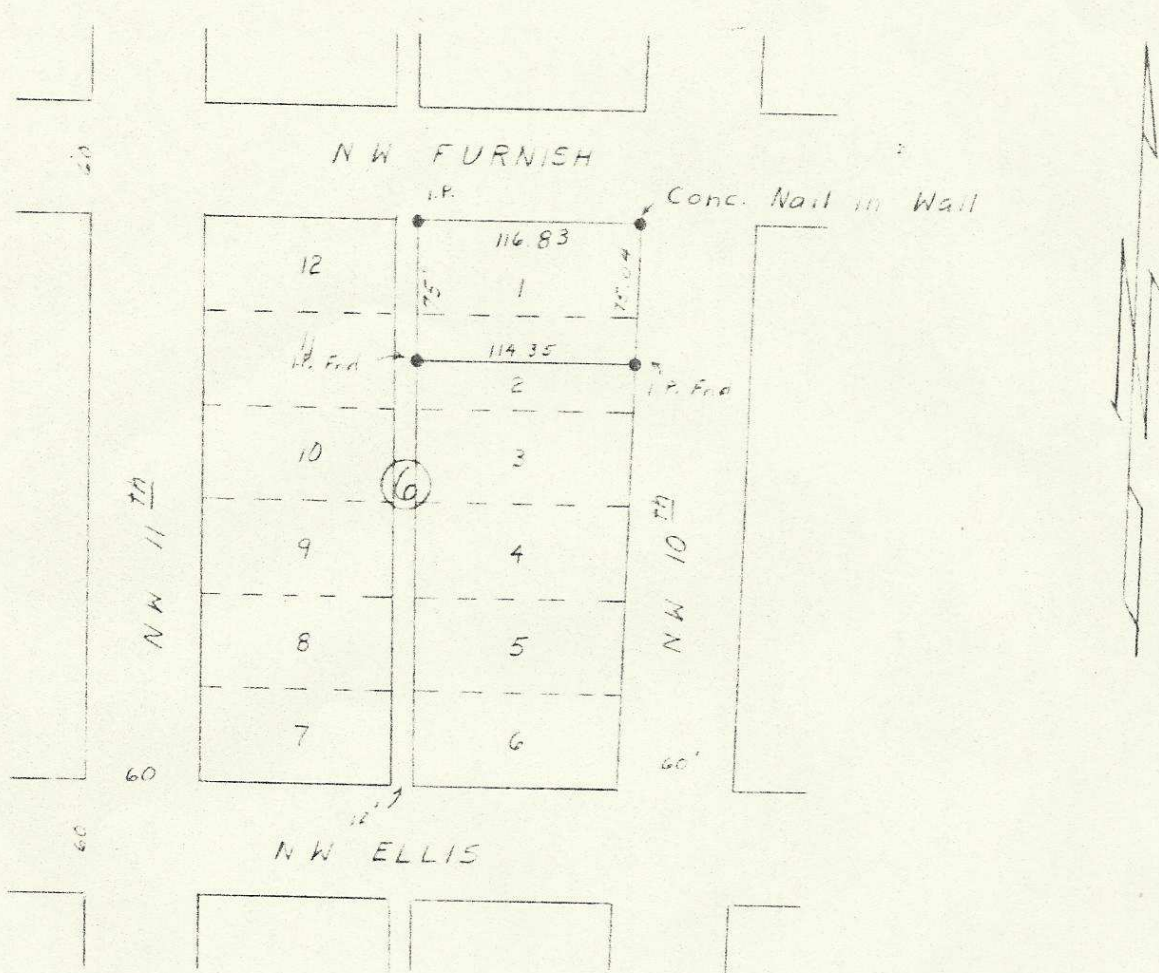

Hayes & Harris

SE<sup>4</sup> SW<sup>4</sup> (3)

HAYES AND HARRIS

SURVEY FOR

WM. MORRISON Q-188-Ax

LOT 1 & N25' LOT 2, COLES ADD.  
PENDLETON, OREGON

SCALE	DATE	DRN. BY	DRNG. NO.
1"=100'	3/15/63	WOH	63-176