

ent No 1.

North Reservation Boundary.

orig

Q-252-Ax

30'	100.0 1/4"	100.0 1/4"	100.0 1/4"	100.0 1/4"	100.0 1/4"	100.0 1/4"
56.67	16 98.76	1	60.97	16	1	16
50.00	15 97.70	2		15	2	15
"	14 96.63	3		14	3	14
"	13 95.52	4		13	4	13
"	12 (29) 94.48	5		12 (38)	5	12
"	11 93.39	6		11	6	11
"	10 92.31	7		10	7	10
50.01	9 91.24	8		9	8	9
23rd			22nd		21st	


S. W. Emigrant Street.



Plat Showing -  
Blocks 29 & 38 of Reservation  
Addition to City of Pendleton,  
Oregon.

Scale - 1" = 100'  
Surveyed and platted July - 1947  
By W. E. O. Criger - C. E.

For:

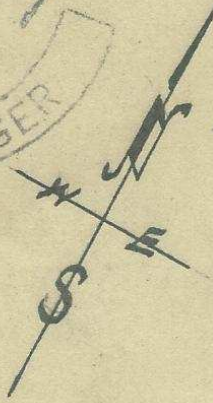

NW 1/4 SW 10  
SE 1/4 NE 10

Q-252-Ax

489