



9

Celia Peebler

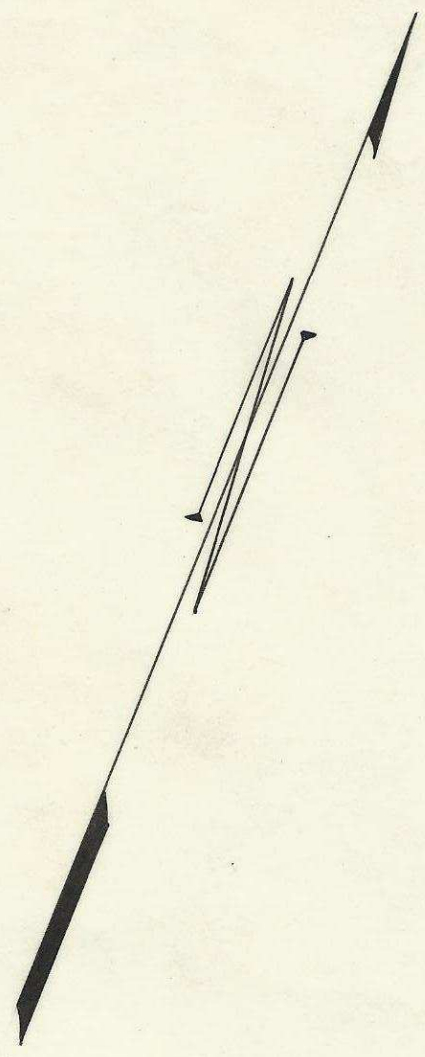

Q-254-Ax

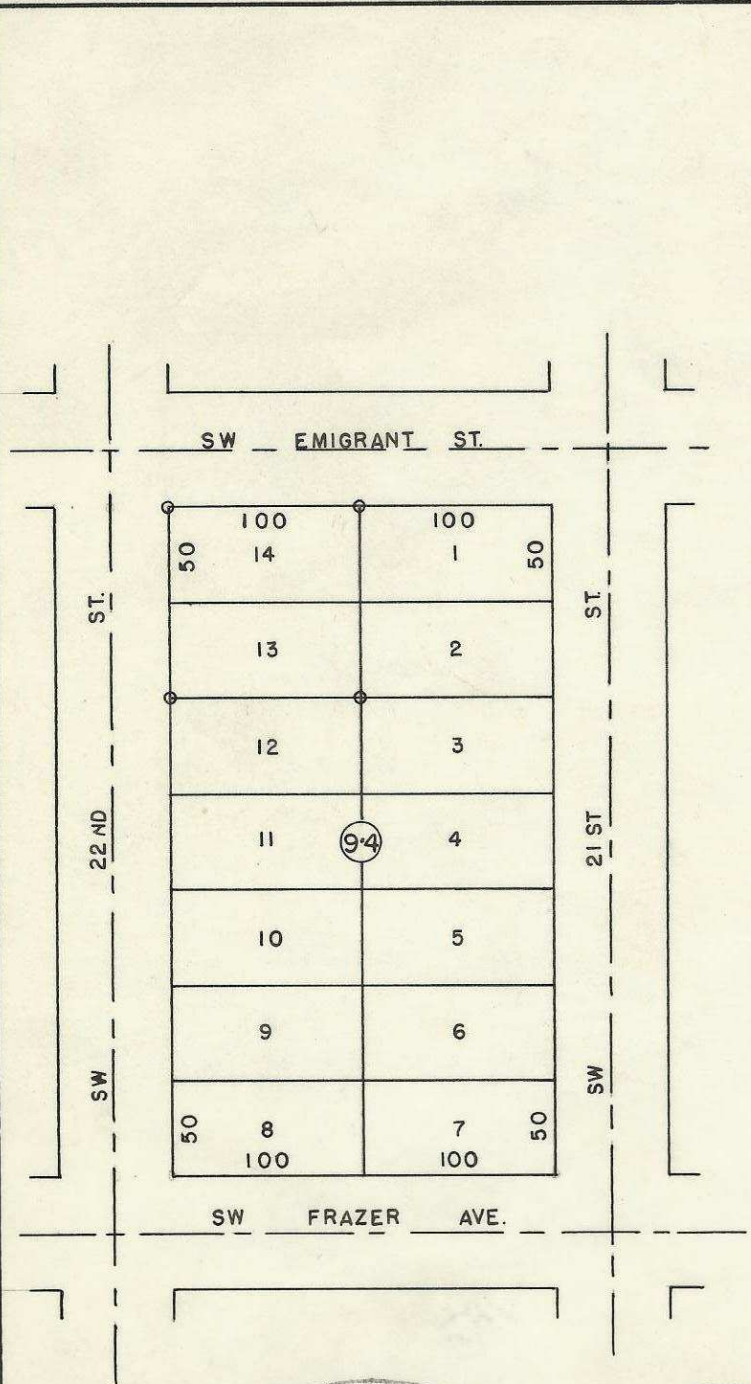

HAYES & HARRIS ENGINEERING		
SURVEY FOR CELIA PEEBLER		
LOTS 13 & 14, BLK. 94, RESERVATION ADD'N. PENDLETON, OREGON		
SCALE 1"=100'	DATE 2- 28-55	DRAWN BY W. O. H.

T2N R32 Sec. 10C