


②-255-Ax  
OR 19

○ Denotes 1/2" Iron Pin unless otherwise so specified

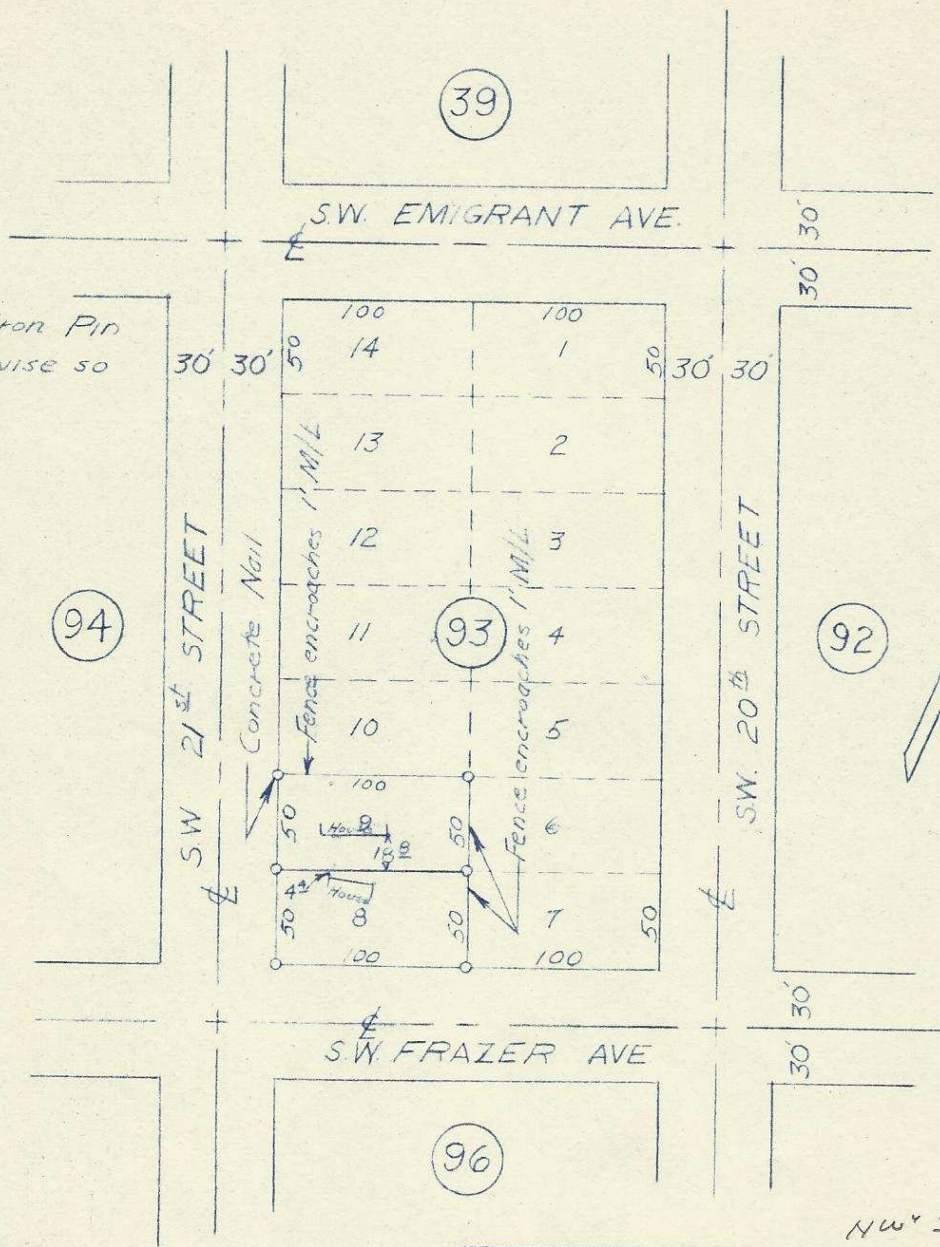

Wayne O Harris

HAYES AND HARRIS			
Survey For			
BOB COLLINS			
LOTS 8 & 9		BLOCK 93	
RESERVATION ADDITION			
PENDLETON, OREGON			
SCALE	DATE	DRN. BY	DRGN. NO.
1"-100'	21/JAN/61	L.H.A.	61-145

②-255-Ax

862