


OR 17
Q-290-AX

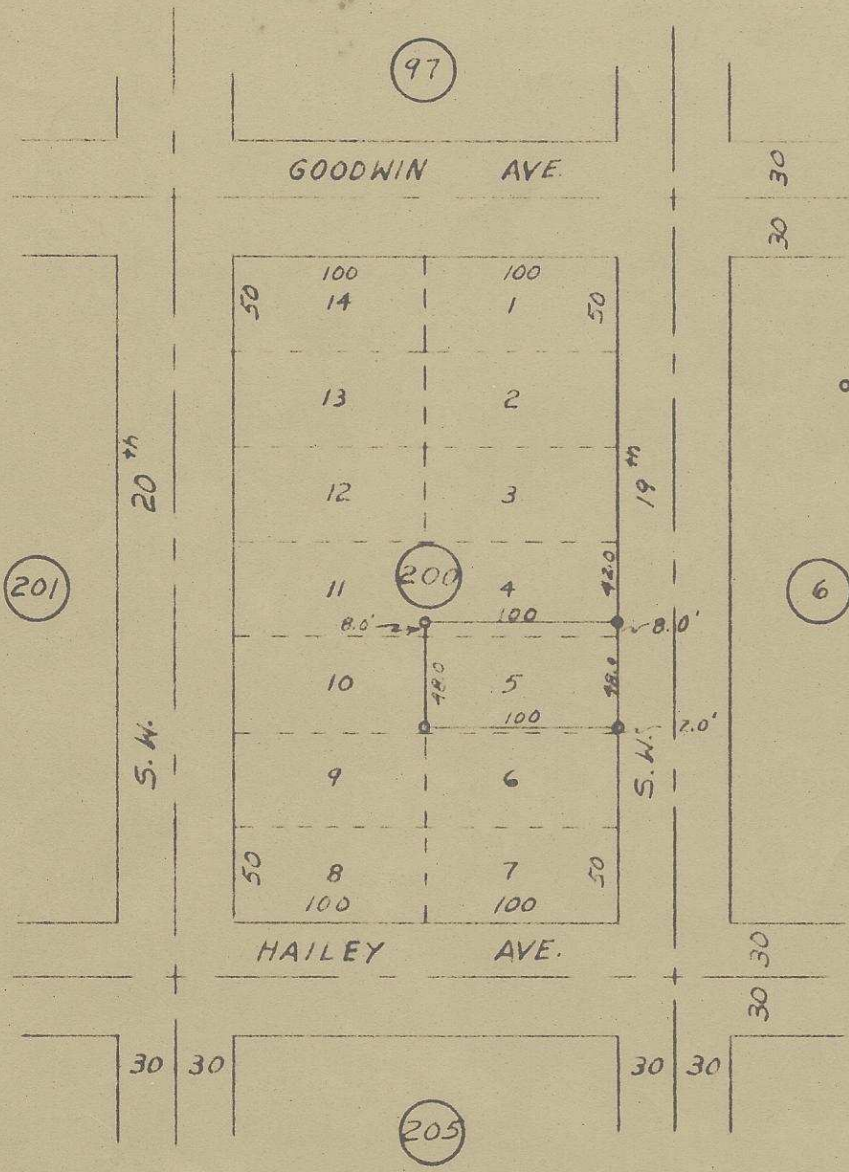

Wayne Q Harris

SW⁹S¹⁰W¹⁰

HAYES AND HARRIS			
Survey For			
R. J. KELLEY			
S'ly 8' of Lot 4 Block 200			
N'ly 48' of Lot 5			
Reservation Addition			
Pendleton, Oregon			
<i>Q-290-AX</i>			
Scale	Date	Drn. By	Drng. No.
1"-100'	5/11/60	WQH	60-124