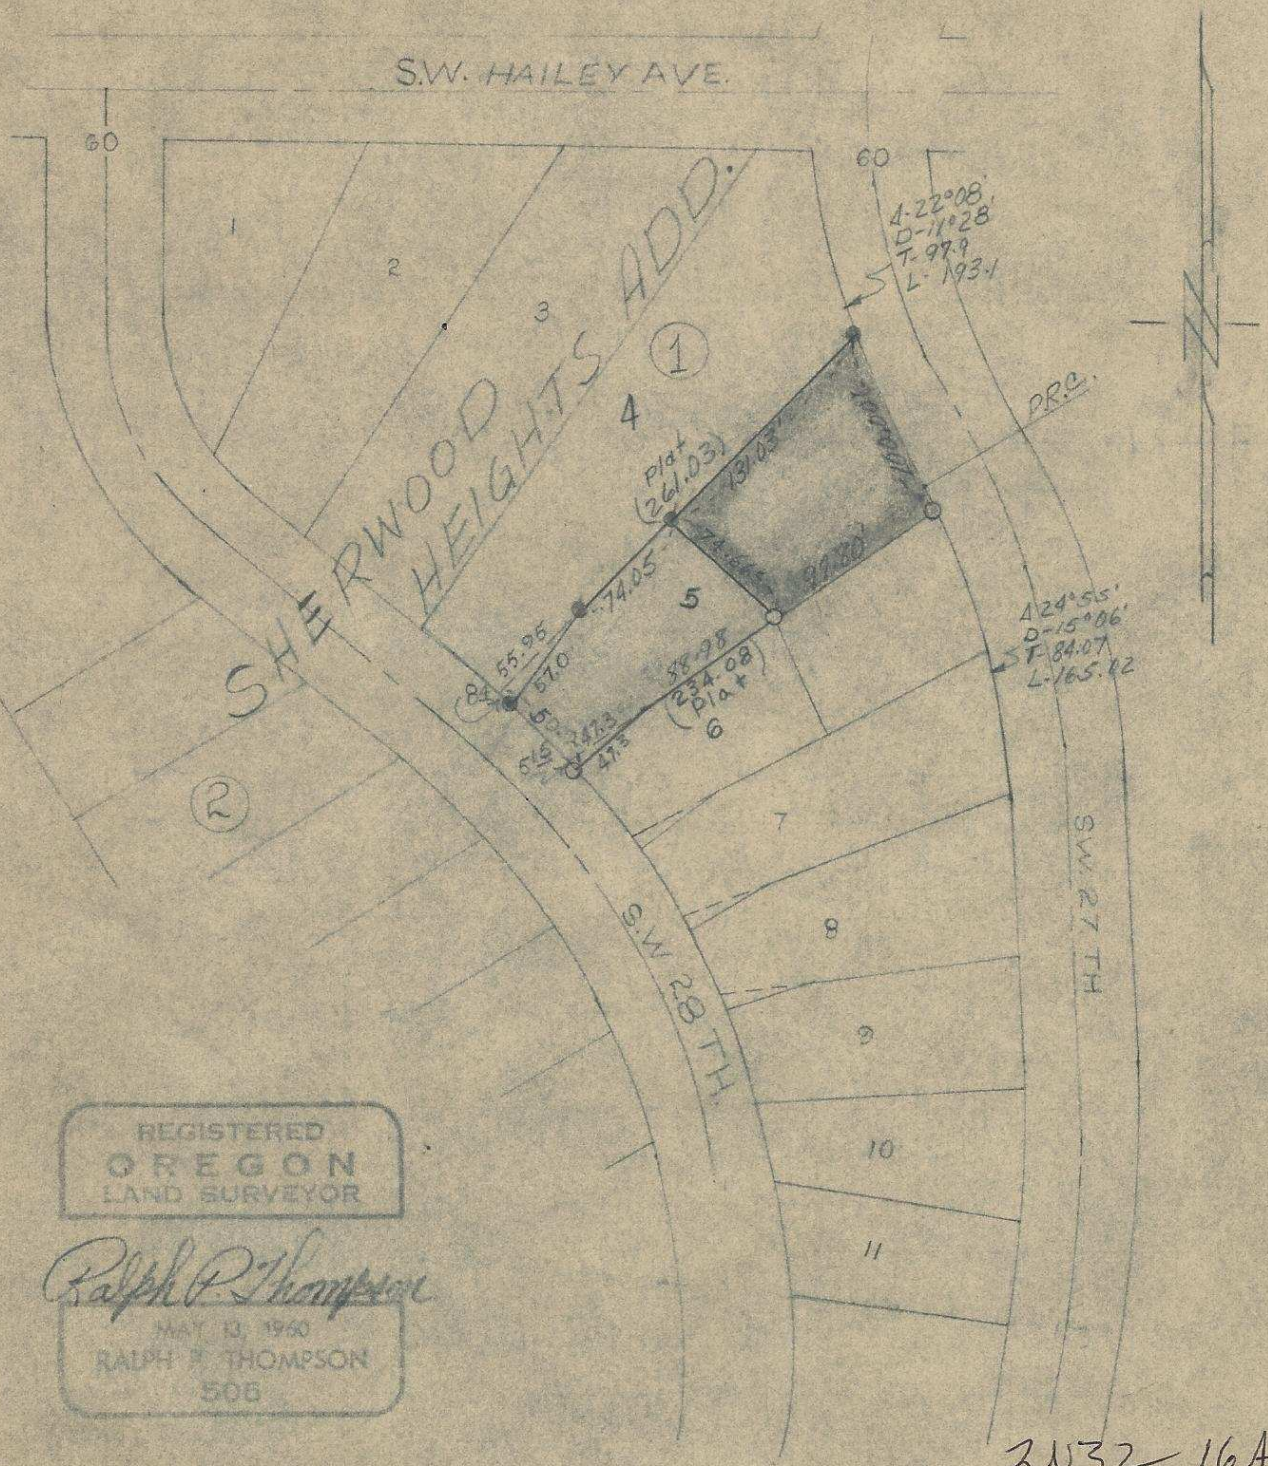

REGISTERED
OREGON
LAND SURVEYOR

Ralph P. Thompson

MAY 13, 1960
RALPH P. THOMPSON
506

2N32-16AA

Property Survey For
L. E. Smith.
lot 5 Blk. 1 Sherwood Hgts. Add.
Pendleton, Oregon

Date: 8/27/62 | Scale: 1" = 100'

Ralph P. Thompson
Land Surveying
Pendleton, Ore.

• Indicates Iron Pins Set

○ Indicates Iron Pins Fnd.

Q-392-A