


Box 47 John Fix

Plat of Relocation Survey

for

JOHN FIX

Located in SW⁴ Sec. 16; T.2 N.; R.32 E.; W.M.

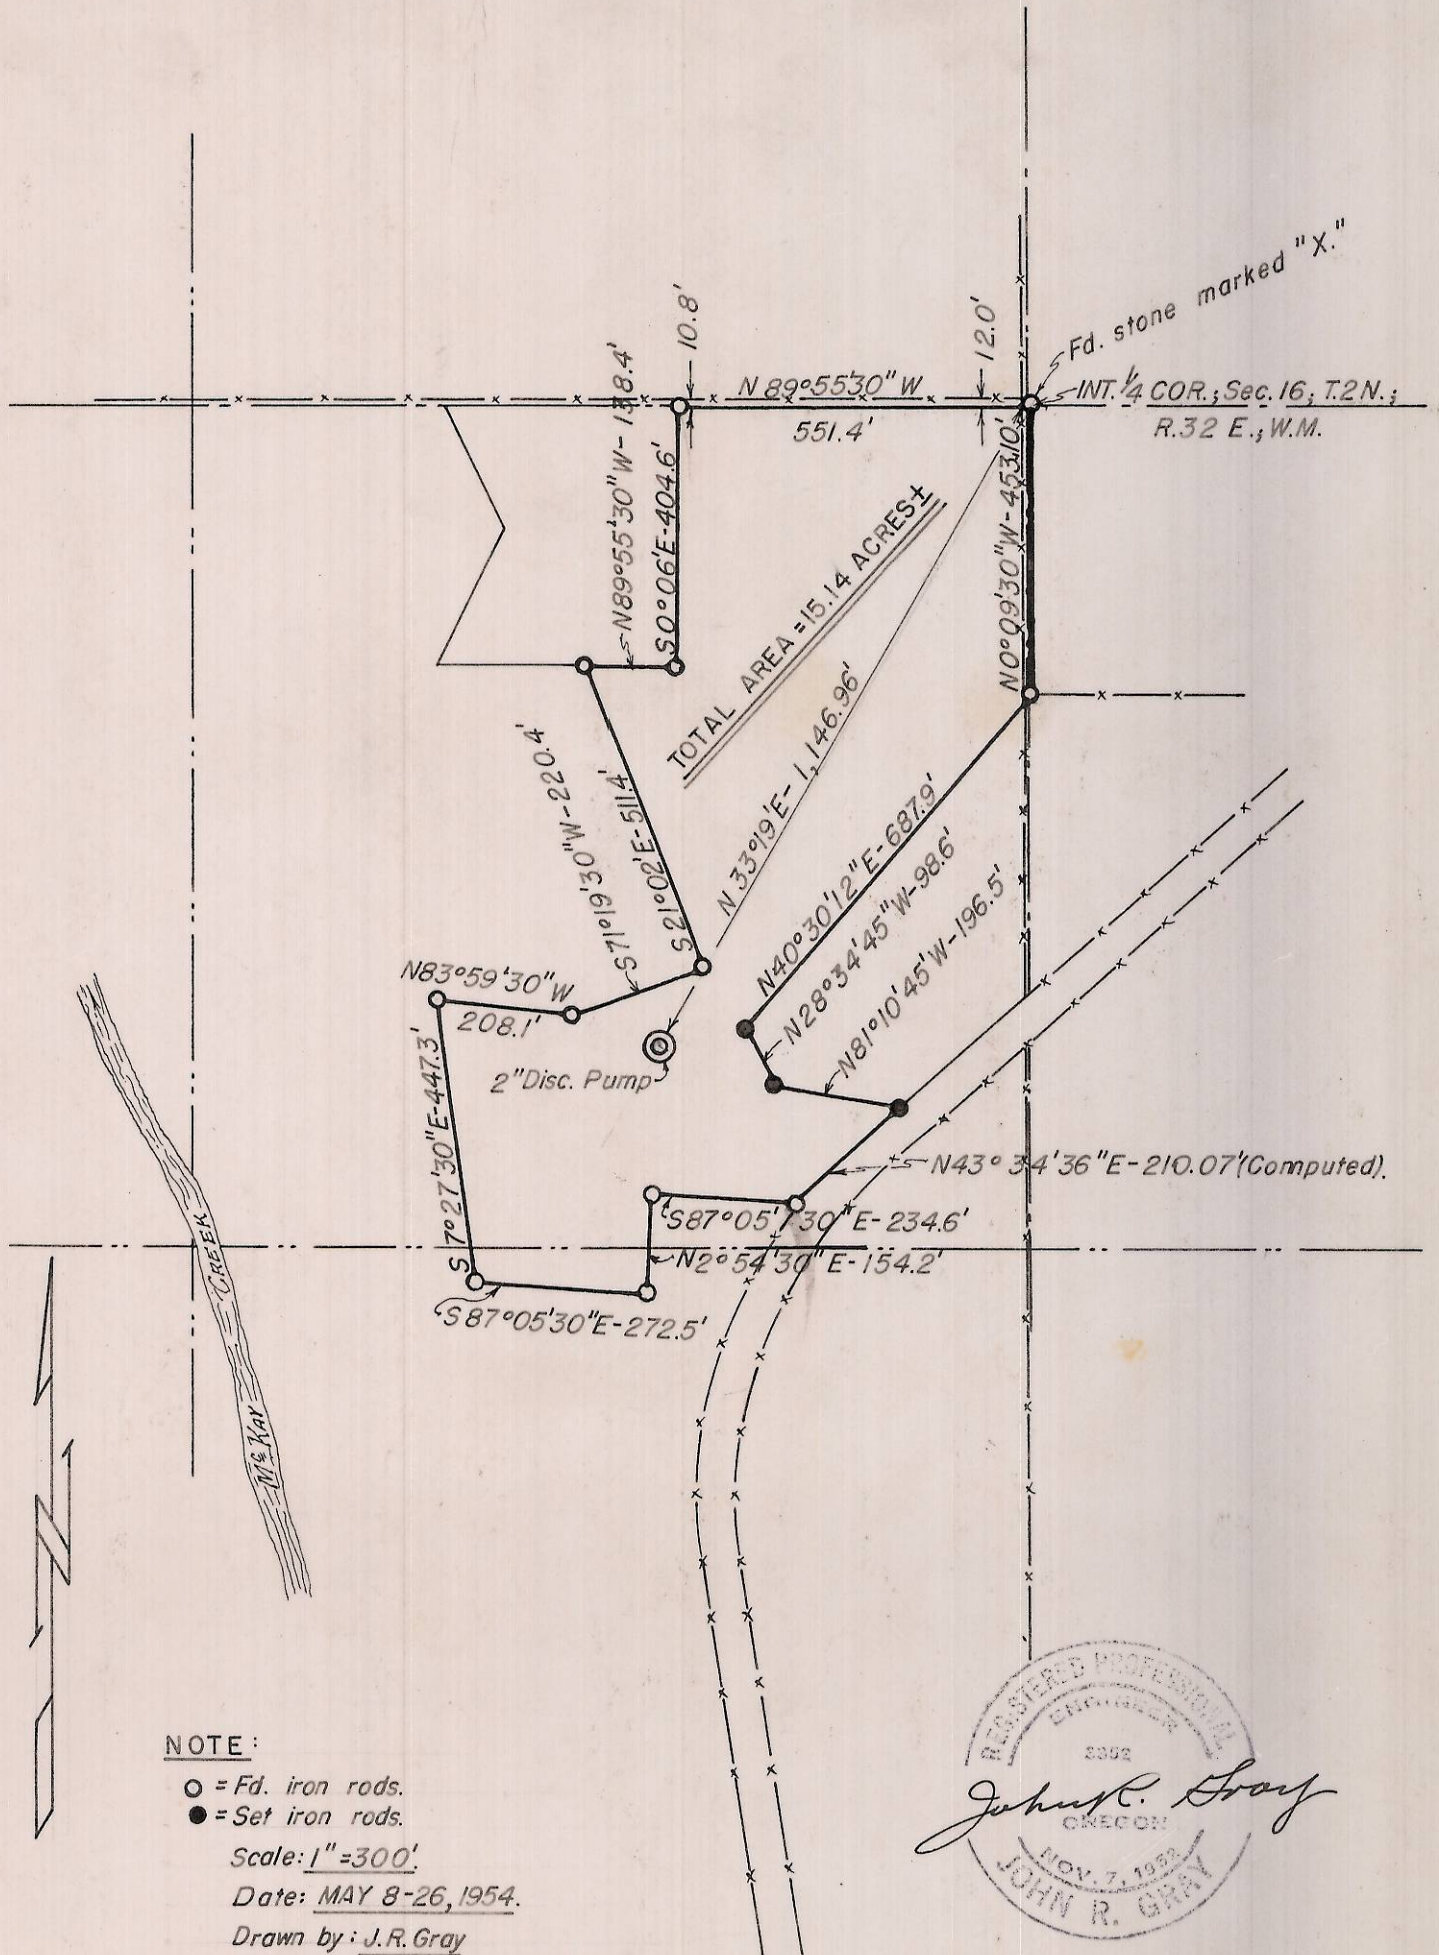

NOTE:


- = Fd. iron rods.
- = Set iron rods.

Scale: 1" = 300'

Date: MAY 8-26, 1954.

Drawn by: J.R. Gray

Field crew: Gray & Cook.

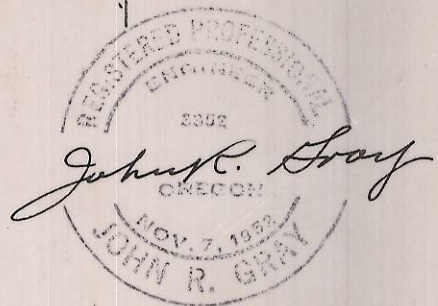

Box 47

Q-421-Ax