


Q-424-AX

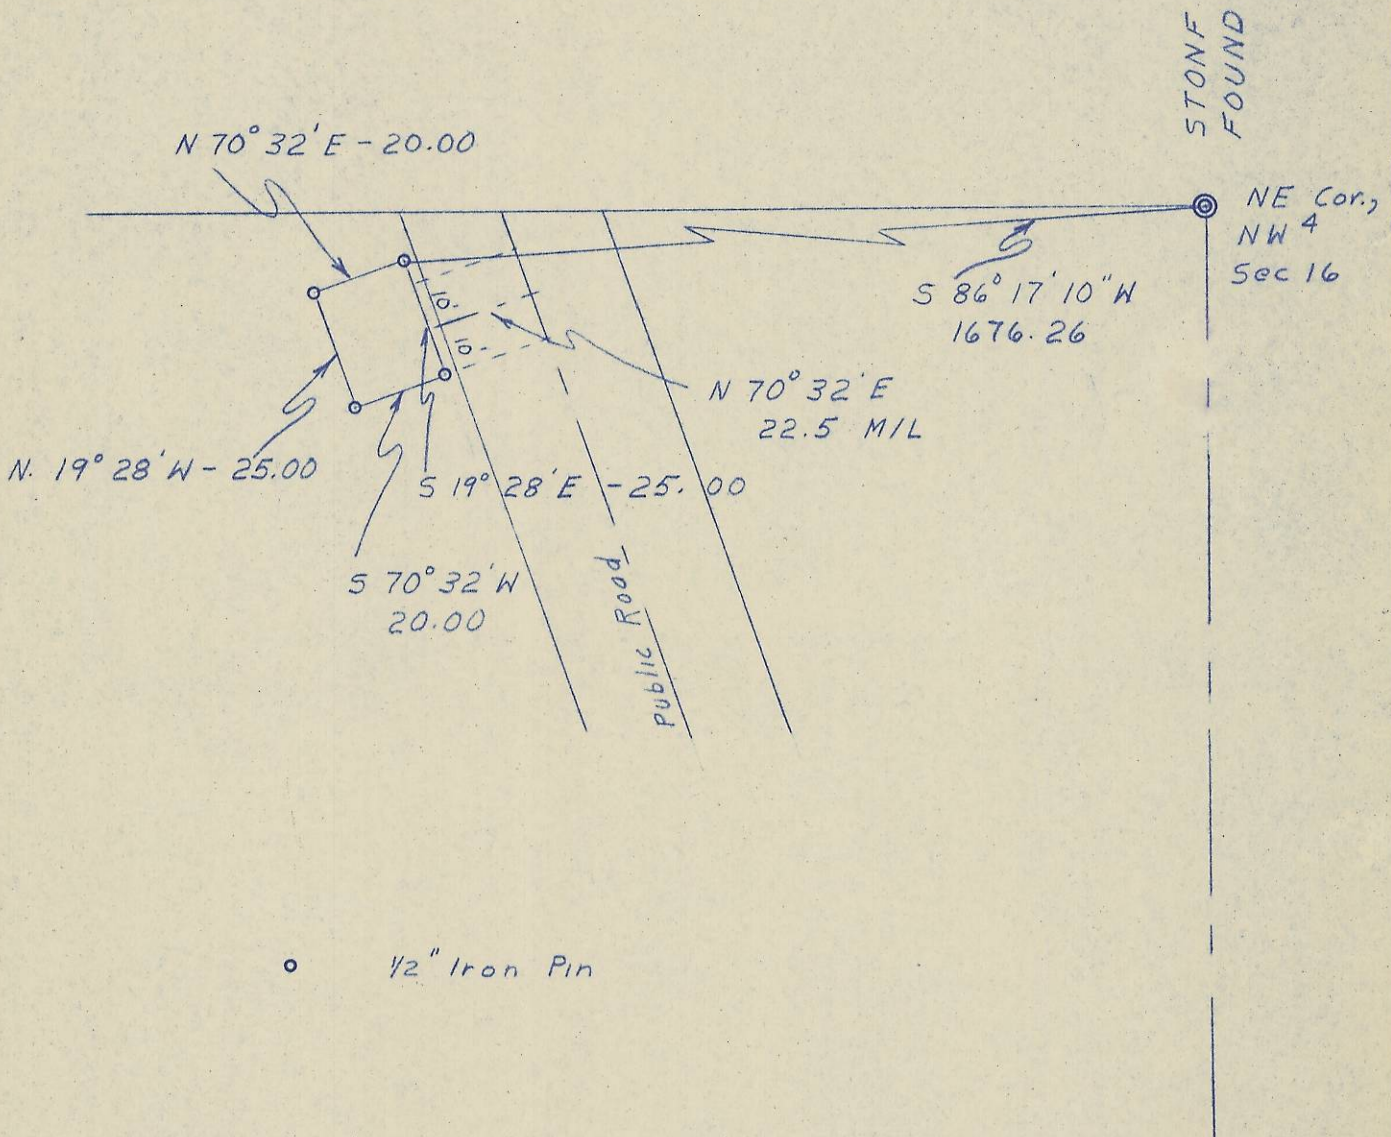

REGISTERED
OREGON
 LAND SURVEYOR

Wayne O. Harris

MAY 6, 1953
 WAYNE O. HARRIS
 346

HAYES AND HARRIS

SURVEY FOR
 CASCADE NATURAL GAS CO.

REGULATOR SITE IN SEC. 16 ^{BA}
 T. 2 N., R. 32 E., W.M.

Q-424-AX

SCALE	DATE	DRN. BY	DRNG. No.
1"=40'	7/11/61	WOH	61-156

orig