


Orig  
Q-498-Ax

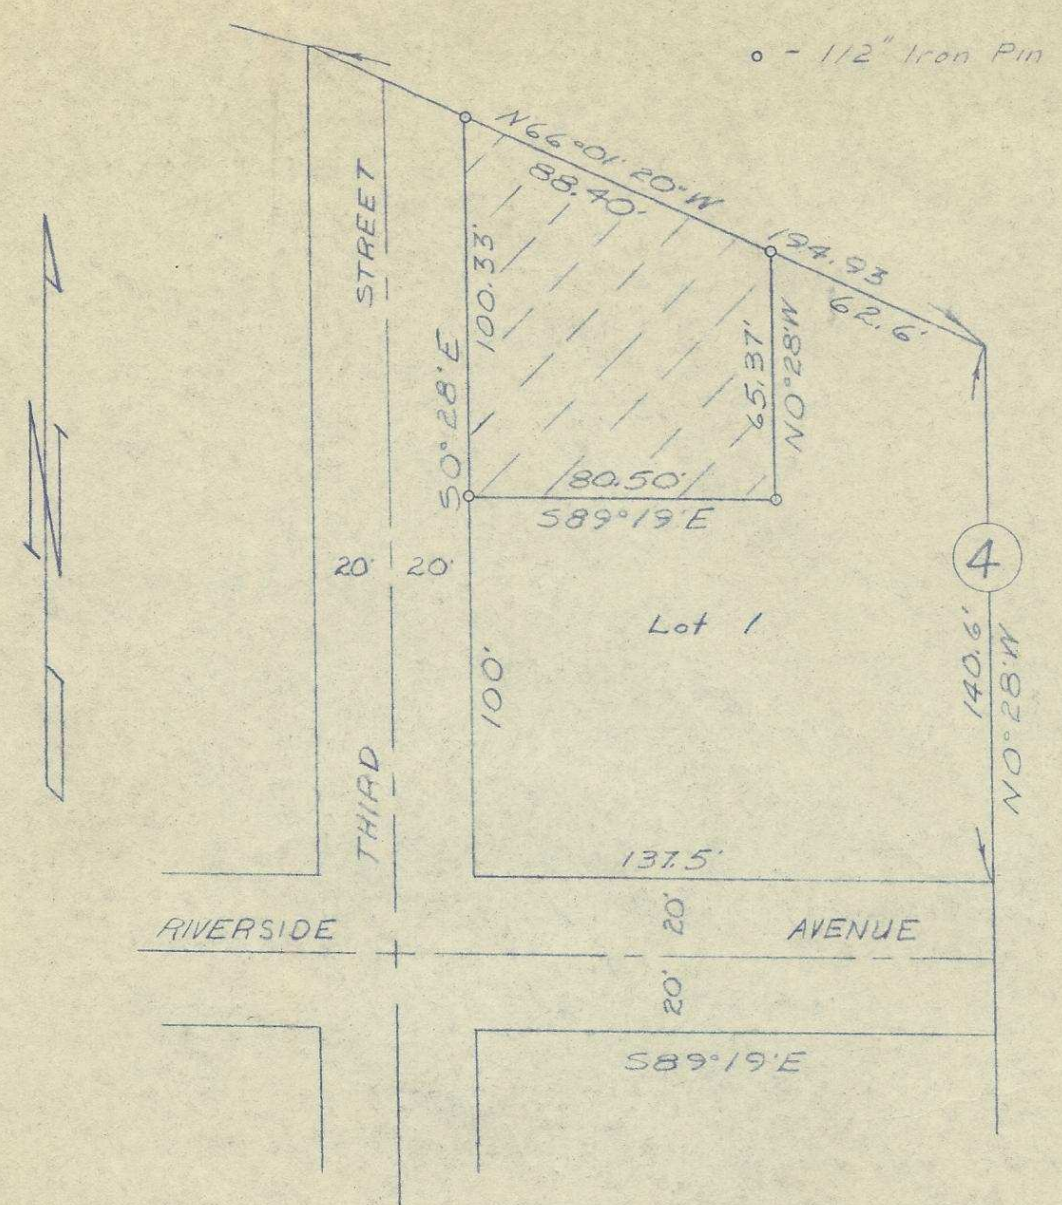

REGISTERED  
OREGON  
LAND SURVEYOR

*Wayne O. Harris*

WAYNE O. HARRIS  
346

62N-33E WK

HAYES AND HARRIS

Survey For  
OLIVER C. CALHOUN

Parcel In Lot 1, Block 4

CRISPIN RIVERSIDE TRACTS  
PENDLETON, OREGON

206

| Scale    | Date   | Drn. By | Drng. No. |
|----------|--------|---------|-----------|
| 1" = 50' | 6/4/60 | T.F.    | 60-132    |