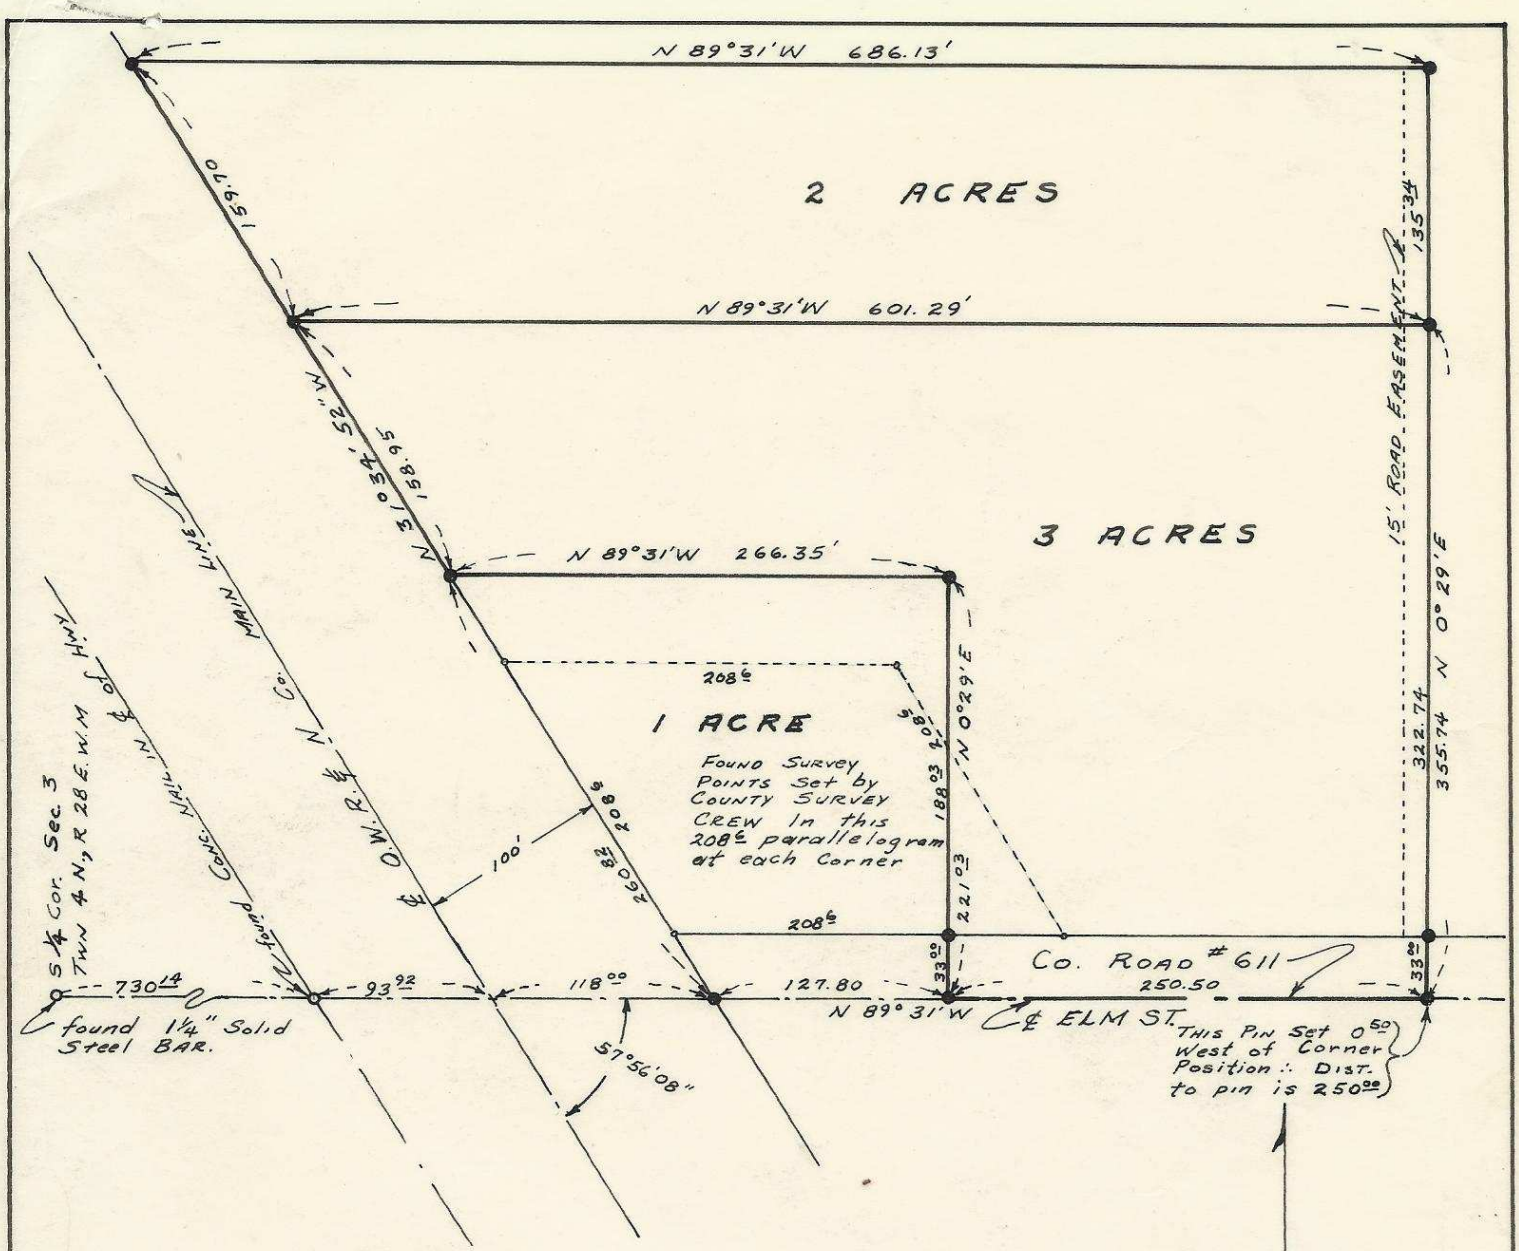

LEGEND

● - - - - - - - - - - ½" x 24" iron rods Set by this survey.

○ - - - - - - - - - - Points found & Set by others.

4N28 3D

REGISTERED PROFESSIONAL ENGINEER 3758 Stanley G. Wallulis OREGON OCT. 22, 1954 STANLEY G. WALLULIS

SURVEY FOR Mr. GOSNEY

Scale 1" = 100'	Date: 2-8-61

STANLEY WALLULIS
CONSULTING ENGINEER
P.O. Box 91
Pendleton Oregon

Q-568-Ax