RECORD OF SURVEY No. 406

Pg. 272

Survey of Section 31 T. 4 N.; R. 35 E. W. M.

BINFORS & PRUDHOMME COMPANY, PRINTERS AND BOOKBINDERS, PORTLAND

Links

Survey for J.W. Pinkerton, E.A. Dudley, Alick Johnston, Kirk Estate et el,

April 2. to 4- 1915. E.A. Dudley, Alick Johnston --- Chainmen.

J.W. Pinkerton --- Flagman.

Made survey as shown by plat below.

Old corners found marked -- Found.

Corners established marked -- Est.

Red, refers to Gov. distances used.

Willard Bradley
County Surveyor.

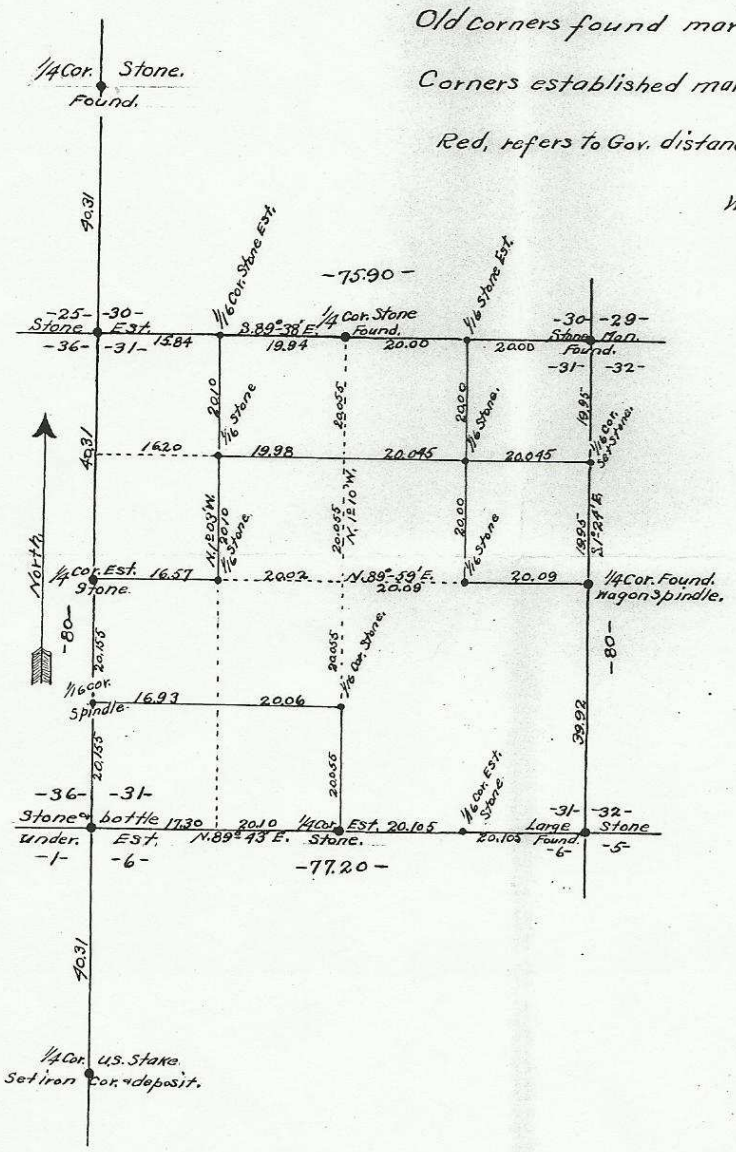

Q-721-Ax