SURVEY FOR WARD & IRENE R OTIS

LOTS 9, 10, 11, 12 in in BLK 42

COE'S 1ST ADD'N TO STANFIELD in

UMATILLA COUNTY, OREGON

MAY 22, 1960

SCALE 1" = 200'

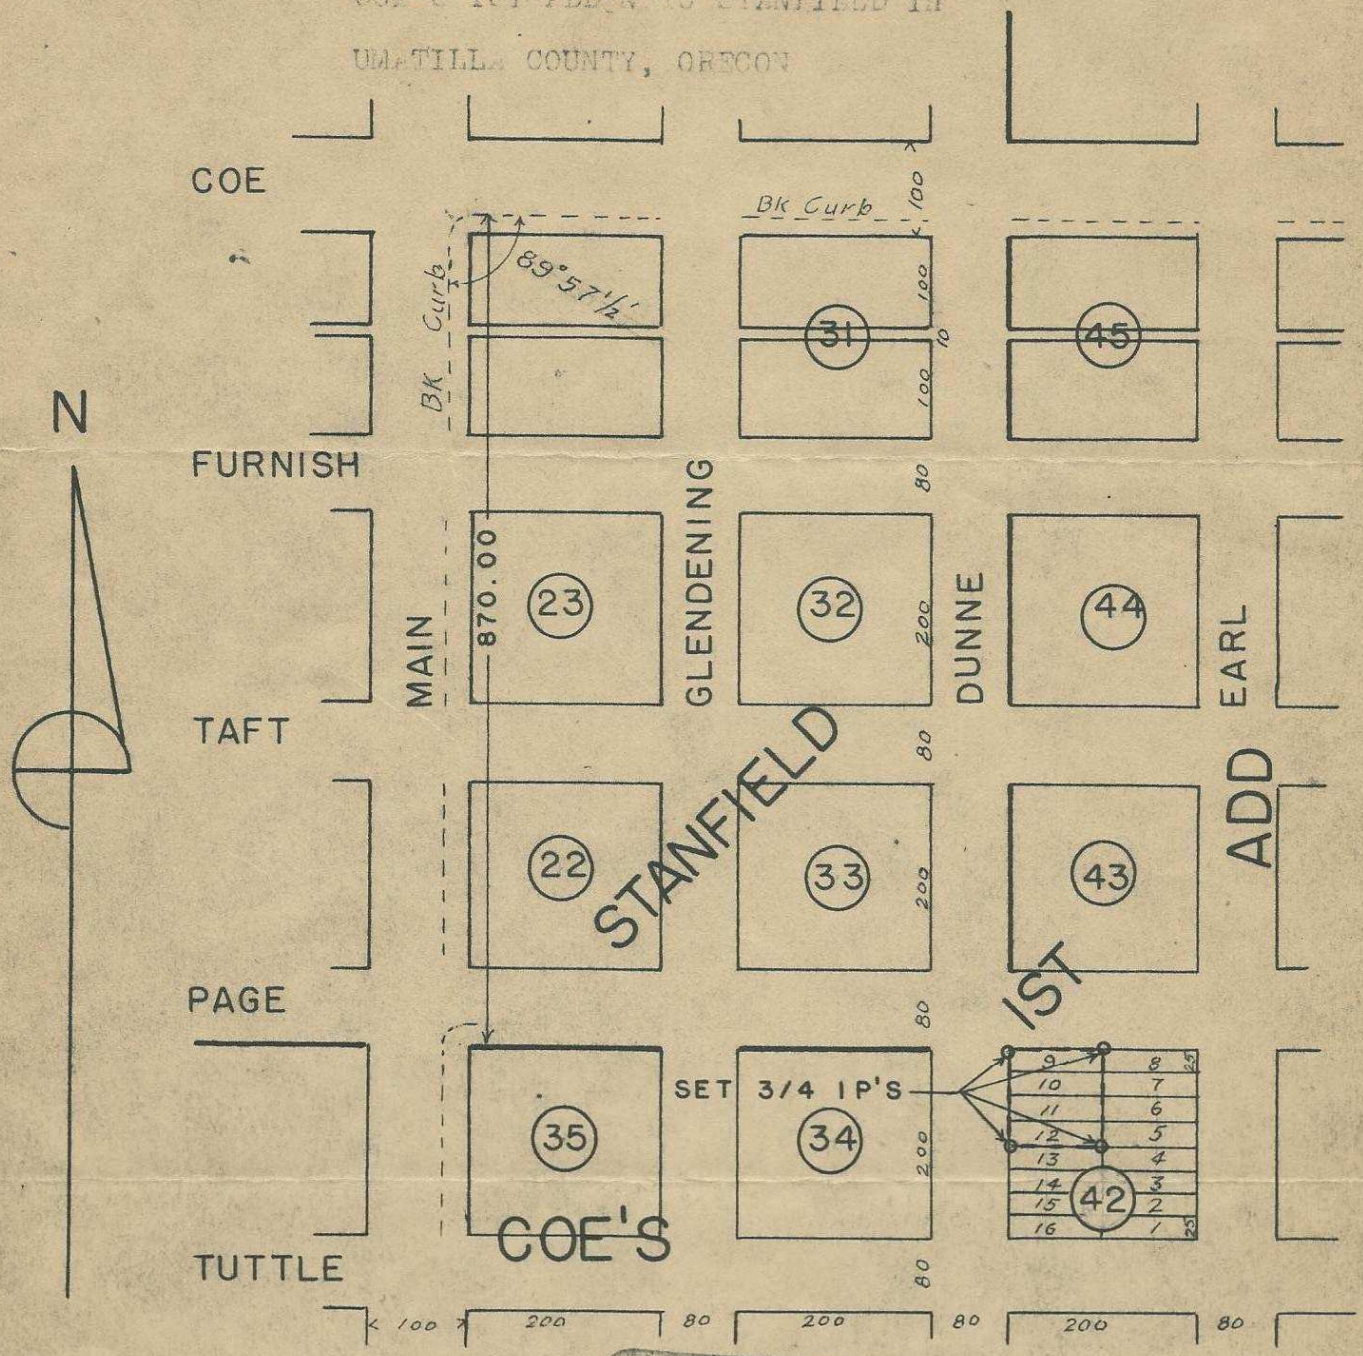

REGISTERED
OREGON
LAND SURVEYOR

Donald C. Kyle

OCTOBER 24, 19
DONALD C. KYLE
456

541

Q-1022-A

ORIG