


5N35 12AC

SURVEY IN BL. 2, RIVERSIDE ADD.

MILTON-FREEWATER, OREGON

Surveyed for Bernice Larrabee by Victor M. McLind

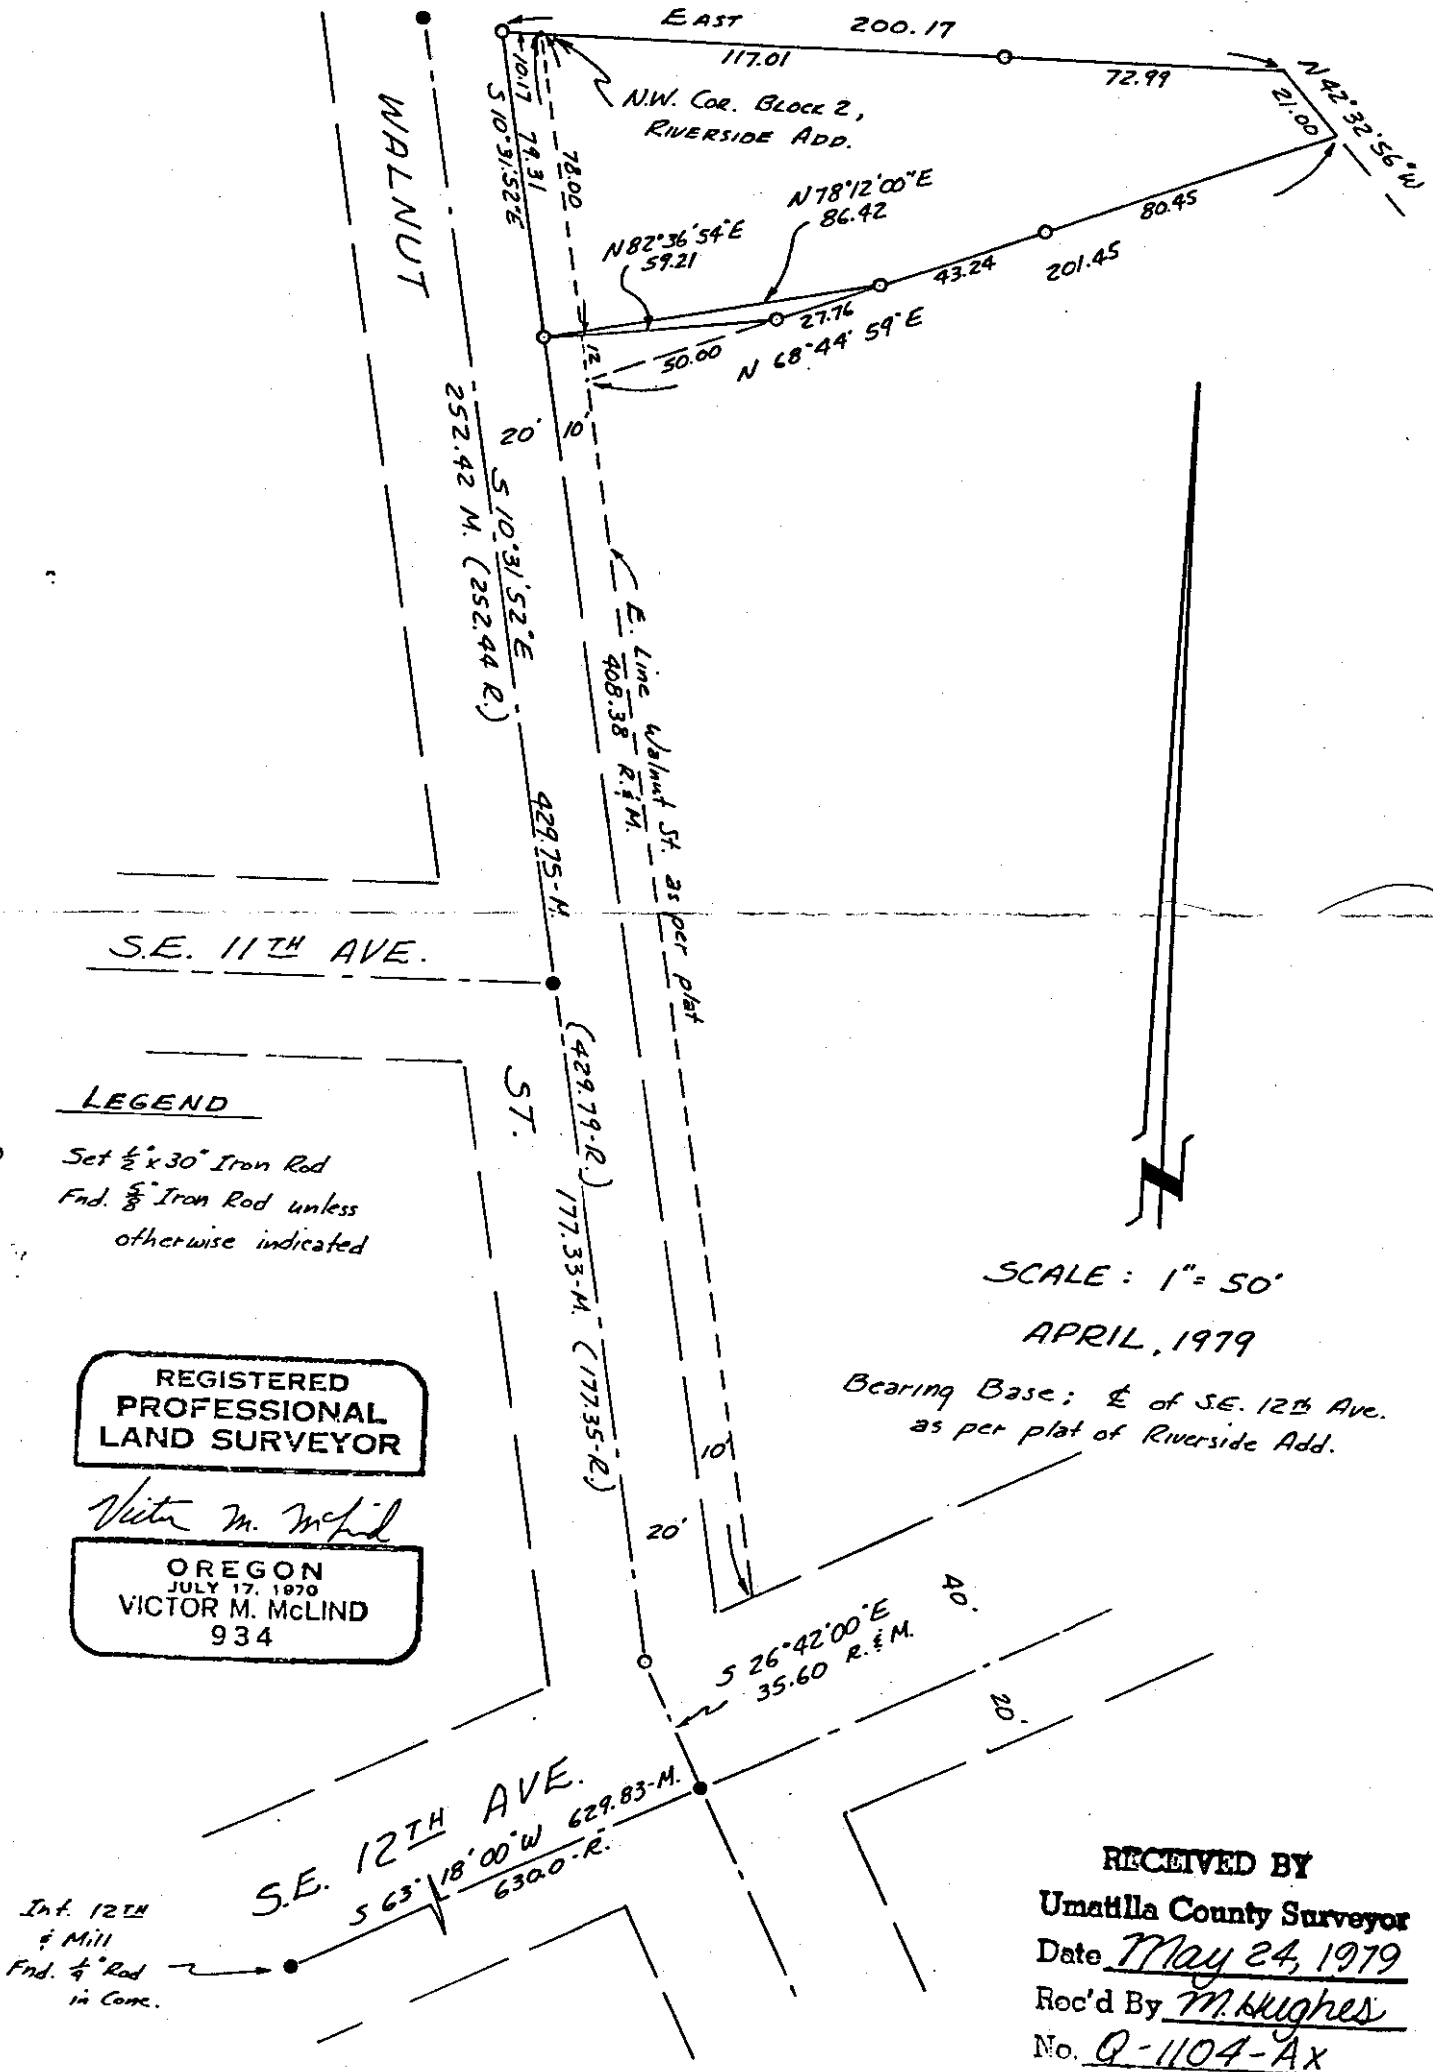

Q-1104-Ax