


All points on highway marked with railroad spikes.
 Areas shown include rights of way for highway and ditch.

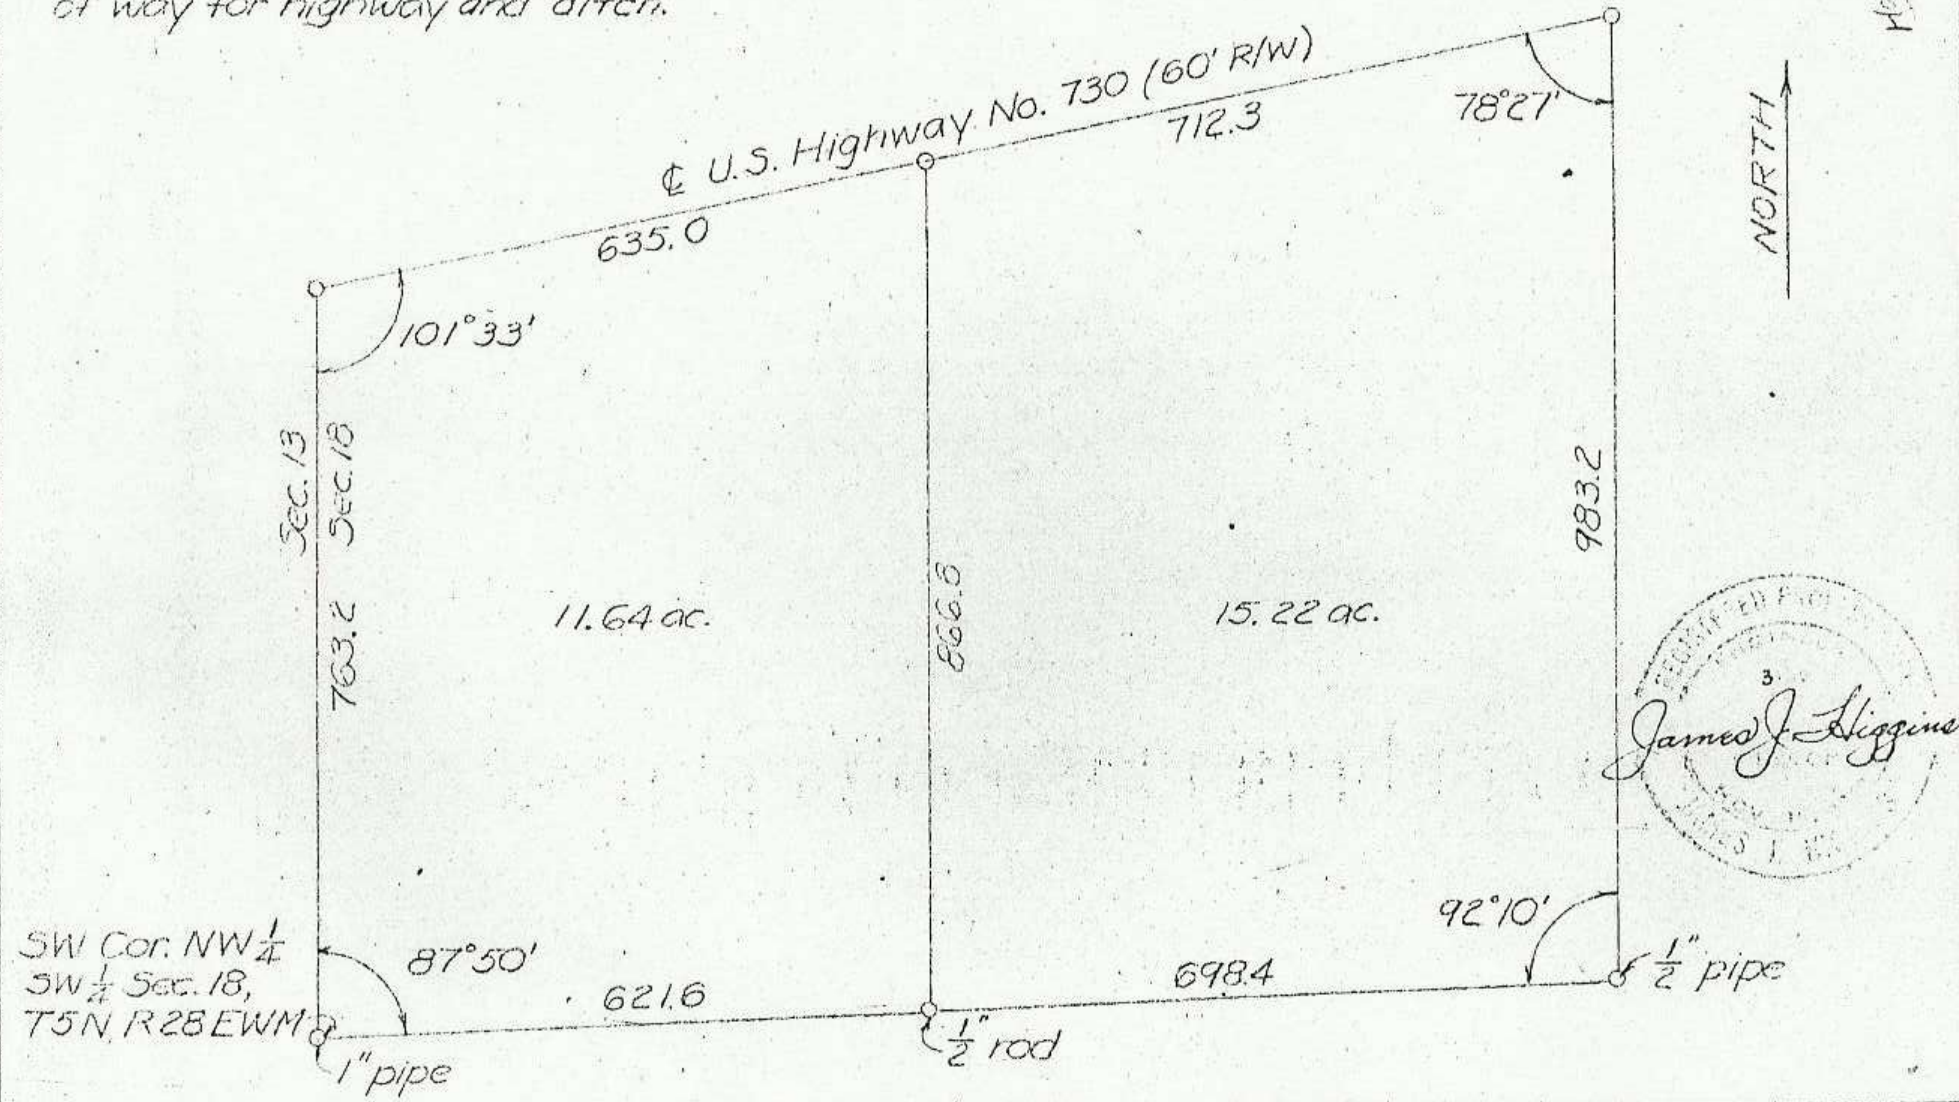

SURVEY
 FOR
 CLARENCE R. POST
 UMATILLA, OREGON

Q-1565-AX

1A⁸