


PLAT  
OF  
SECTION 15 T 6 N R 34 E W.M. OREGON  
In Umatilla County, Surveyed and  
Platted June 1951 By H.L. Melton and  
W.E.O. Criger. Scale 1" = 1000 Ft.

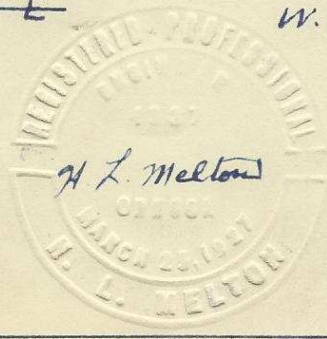

To Frank Hayes-

W. E. O. CRIGER  
CONSULTING ENGINEER

Kressler + Holmes:

S. E/4 Sec. 15 - T. 6 N., R. 34 E., Y. M.

Memorandum Field notes

We located and found the  $3/4$  cor. of Sec. 15. (Marked)  
we then ran east on the south line of Sec. 15 to  
the S. E. corner of said Sec. 15 - (2532 ft.) where we  
dug up and found the marked stone which we  
referenced in -.

We ran a line thru the S. E/4 from the So. line  
north to the E. W.  $\frac{1}{4}$  of Sec. 15.

We then located the Mile post 21 on the Orig. Wash-  
state line which is a large buried stone marked "21 M."  
we then ran 645.5 ft. to the N. E. cor. of Sec. 15 where


we found a yellow stone 10" x 16" by 5" thick.

we ran south on the east line of Sec. 15 - 798.6' to

the E/4 corner; thence west to the center of

the section where there is buried stone.

(There is a concrete slab on the State line

(2' x 3' square, marked thus , 247 ft. west of

mile post no. 21.)  
we set a post midway between the E/4 cor.

and the center of sec. 15.

we then ran a true line from the south

sec. line north, through the middle of the S E/4

of sec. 15 to the post set on said E-W  $\frac{1}{4}$  of

Sec. 15. — map filed —

W E O Criger.