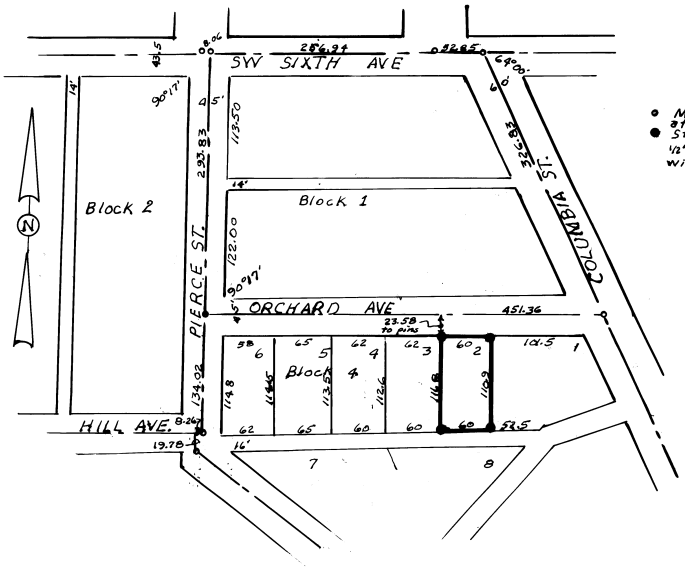

- Monuments found were reset for city after 1975 construction project
- Steel pins set
  1/2" x 24" reinforcing bar marked with brass washer LS 1341

SURVEY FOR
DON EDWARDS
Lot 2 Block 4 Black's Addn
Milton-Freewater, Ore.
NW¼ Sec. 12 T.5N., R.35 E.W.M.
Scale 1" = 100'
Mar. 1, 1989

Guy W. Streamer
930 Home St.
Walla Walla, WA. 99362
Professional Land Surveyor

REGISTERED
PROFESSIONAL
LAND SURVEYOR
Guy W. Streamer Jr.
OREGON
SEPTEMBER 23, 1977
GUY W. STREAMER, JR.
1341

NARRATIVE

From railroad spikes found as shown on drawing marking centerlines of Pierce Street and Orchard Avenue angle was turned at intersection and corners of Lot 2 were set in accordance with subdivision drawing.

89-142-B

Survey 1007